

Pearl River
W 2058

MISSISSIPPI
BOARD OF WATER COMMISSIONERS
416 North State Street
Jackson, Mississippi 39201

WATER WELL DRILLERS LOG


11-16-82 19 Penton Well Serv Pearl River
date well completed firm name county well located

LANDOWNER: <u>Wood Treating Inc</u>	description of formations encountered	from	to
<u>Picayune MS</u> (mailing address)	<u>Surface Clay</u>	<u>0</u>	<u>30</u>
	<u>Sand</u>	<u>30</u>	<u>65</u>
WELL LOCATION: sec. <u>15</u> T. <u>6</u> N R. <u>17</u> E S W <u>0</u> miles <u>SW</u> of <u>Picayune</u> (distance) (direction) (nearest town)			
WELL PURPOSE: <u>CA</u> (home, irrigation, municipal, industrial)			
WELL COMPLETION DATA:			
(1) diameter (inches) <u>4"</u>			
(2) total depth (feet) <u>65'</u>			
(3) static water level (feet) <u>24</u> below top of ground.			
(4) casing <u>PVC</u> <u>60'</u> (material) (depth) <u>4"</u> (size) if telescope see back.			
(5) screen <u>5'</u> <u>60'</u> (length) (depth to top) <u>4"</u> <u>PVC</u> (size) (material)			
(6) pump <u>1/2</u> <u>15</u> (HP) (yield gpm) <u>Elec</u> (type power)			
(7) electric log <u>No</u> (yes or no)			
(organization running log)			
(8) how well bottom plugged <u>BW Valve</u>			
DRILLERS REMARKS:			

RECEIVED
DEC 20 1982
DEPT. OF NATURAL RESOURCES
BUREAU OF LAND & WATER RESOURCES

If well telescopes please sketch and show depths.

GROUND LEVEL

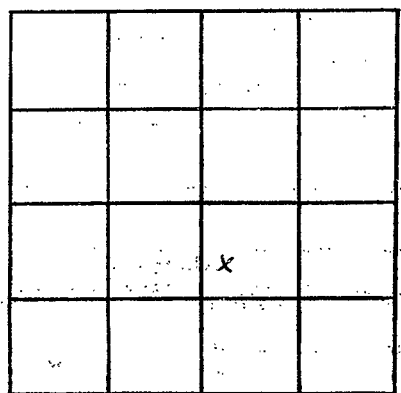

SECTION 15

Please indicate well location X.

ADDITIONAL INFORMATION

A series of horizontal lines for writing additional information, starting below the 'ADDITIONAL INFORMATION' header and extending to the bottom of the page.

If more than one screen, show locations of each on sketch.