

Pearl River  
W W  
2000

MISSISSIPPI  
BOARD OF WATER COMMISSIONERS  
416 North State Street  
Jackson, Mississippi 39201

WATER WELL DRILLERS LOG

11-19-82 19 Penton Well Serv Pearl River  
date well completed firm name county well located

LANDOWNER: Wood Treating Inc

description of formations encountered	from to	
<u>Surface Clay</u>	<u>0</u>	<u>40</u>
<u>Sand</u>	<u>40</u>	<u>65</u>

Picayune MS  
(mailing address)

WELL LOCATION:

sec 15 T 6 N R 17 E  
S W  
0 miles SW of Picayune  
(distance) (direction) (nearest town)

WELL PURPOSE: EPTA  
(home, irrigation, municipal, industrial)

WELL COMPLETION DATA:

- (1) diameter (inches) 4"
- (2) total depth (feet) 65
- (3) static water level (feet) 22 below above top of ground.
- (4) casing Pvc, 60',  
(material) (depth)  
4"  
(size) If telescope see back.
- (5) screen 5', 60'  
(length) (depth to top)  
4", Pvc  
(size) (material)
- (6) pump 1/2, 15  
(HP) (yield gpm)  
Elec  
(type power)
- (7) electric log no  
(yes or no)

(organization running log)


(8) how well bottom plugged BW Valve

DRILLERS REMARKS:

DEPT OF NATURAL RESOURCES  
BUREAU OF LAND & WATER RESOURCES  
DEC 20 1982  
RECEIVED

If well telescopes please sketch and show depths.

GROUND LEVEL

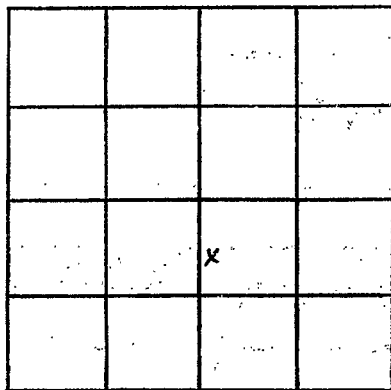

SECTION 15

Please indicate well location X.

ADDITIONAL INFORMATION

If more than one screen, show locations of each on sketch.