

MISSISSIPPI DEPARTMENT OF NATURAL RESOURCES
Bureau of Land and Water Resources
 Southport Mall
 P.O. Box 10631
 Jackson, Mississippi 39209
WATER WELL DRILLERS LOG

Pearl River
Wade

12-2 1982 POUNCEY WATER WELL DRILLING Pearl River
 date well completed firm name county well located

LANDOWNER: Neil Beach
Rt. Pecayine
 (mailing address)

WELL LOCATION:
 sec. 25 T 7 N R. 17 E
2 1/2 miles NW of Richardson
 (distance) (direction) (nearest town)

WELL PURPOSE: Home
 (home, irrigation, municipal, industrial)

- WELL COMPLETION DATA:
- (1) diameter (inches) 2
 - (2) total depth (feet) 354
 - (3) static water level (feet) 30 below top of ground
 - (4) casing PVC (material) 3 1/4 (depth)
 - 2 (size) if telescope see back.
 - (5) screen 10 (length) 3 1/4 (depth to top)
 - 2 (size) PVC (material)
 - (6) pump 1 (HP) 12 (yield gpm)
 - AC (type power)
 - (7) electric log NO (yes or no)
 - (organization running log)
 - (8) how well bottom plugged Sealed.


description of formations encountered	from	to
<u>Top</u>	<u>0</u>	<u>4</u>
<u>sd - Big gravel</u>	<u>4</u>	<u>20</u>
<u>grays to blue</u>	<u>20</u>	<u>110</u>
<u>gumbo</u>	<u>110</u>	<u>142</u>
<u>Brown sd.</u>	<u>142</u>	<u>274</u>
<u>Blue clay</u>	<u>274</u>	<u>358</u>
<u>set to sd. AIR</u>		

RECEIVED
 DEC 23 1982
 DEPT. OF NATURAL RESOURCES
 BUREAU OF LAND & WATER RESOURCES

DRILLERS REMARKS:

If well telescopes please sketch and show depths.

GROUND LEVEL

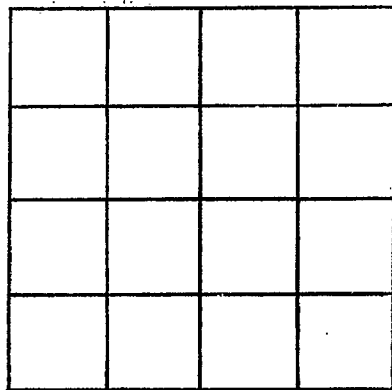

SECTION _____

Please indicate well location X.

ADDITIONAL INFORMATION

If more than one screen, show locations of each on sketch.