

Pearl River
W 2000

MISSISSIPPI DEPARTMENT OF NATURAL RESOURCES
 Bureau of Land and Water Resources
 Southport Mall
 P.O. Box 10631
 Jackson, Mississippi 39209
WATER WELL DRILLERS LOG

7-5 1983 POUNCEY WATER WELL DRILLING Pearl River
 date well completed firm name county well located

LANDOWNER: Delton Bales
Huggo Rd.
Preyune Mrs.
 (mailing address)

description of formations encountered	from	to
<u>top</u>	<u>0</u>	<u>12</u>
<u>sd.</u>	<u>12</u>	<u>52</u>
<u>gravel Big gravel</u>	<u>52</u>	<u>112</u>
<u>clay</u>	<u>112</u>	<u>344</u>
<u>slt.</u>	<u>344</u>	<u>378</u>
<u>sd fine to good</u>	<u>378</u>	<u>435</u>

WELL LOCATION:
 sec. 28 T 7 N R 18 E
1 1/2 miles SE of Preyune Mrs.
 (distance) (direction) (nearest town)

WELL PURPOSE: Home & A/C
 (home, irrigation, municipal, industrial)

WELL COMPLETION DATA:

- (1) diameter (inches) 2
- (2) total depth (feet) 435
- (3) static water level (feet) 30 below top of ground above
- (4) casing PVC 420
 (material) (depth)
2 if telescope see back.
 (size)
- (5) screen 15 430
 (length) (depth to top)
2 PVC
 (size) (material)
- (6) pump 1 16
 (HP) (yield gpm)
AC
 (type power)
- (7) electric log /
 (yes or no)
- (organization running log)

(8) how well bottom plugged Sealed

DRILLERS REMARKS: also
65' Disposal well
10' - old sewer.


DEPT. OF NATURAL RESOURCES
 BUREAU OF LAND & WATER RESOURCES

AUG 26 1983

RECEIVED

If well telescopes please sketch and show depths.

GROUND LEVEL

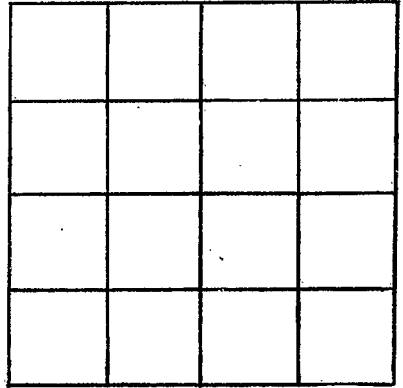

SECTION _____

Please indicate well location X.

ADDITIONAL INFORMATION

If more than one screen, show locations of each on sketch.