

MISSISSIPPI DEPARTMENT OF NATURAL RESOURCES

Bureau of Land and Water Resources

Southport Mall

P.O. Box 10631

Jackson, Mississippi 39209

WATER WELL DRILLERS LOG

Pearl River  
W 2064

POUNCEY WATER WELL DRILLING

Pearl River

6-2 date well completed

firm name

county well located

LANDOWNER: Sunny Flewley

description of formations encountered

from

to

Praying -

City -

(mailing address)

Top  
SD -

0 6

6 - 50' 60

WELL LOCATION:

sec. 4 T. 6 N R. 17 E

Beach St.

(distance) miles (direction) of (nearest town)

WELL PURPOSE: AC Heat

(home, irrigation, municipal, industrial)

DEPT. OF NATURAL RESOURCES  
BUREAU OF LAND & WATER RESOURCES

JUN 3 1983

RECEIVED

WELL COMPLETION DATA:

- (1) diameter (inches) 2
- (2) total depth (feet) 50 - 60
- (3) static water level (feet) 21 below top of ground
- (4) casing Pvc 50-60  
(material) (depth)  
2 if telescope see back.  
(size)
- (5) screen 10 40-50  
(length) (depth to top)  
2 Pvc  
(size) (material)
- (6) pump 1 18  
(HP) (yield gpm)  
AC  
(type power)
- (7) electric log (yes or no)


(organization running log)

(8) how well bottom plugged Sealed

DRILLERS REMARKS: Cool and  
disposal -  
SD - wells -  
Wood Case SD

If well telescopes please sketch and show depths.

GROUND LEVEL

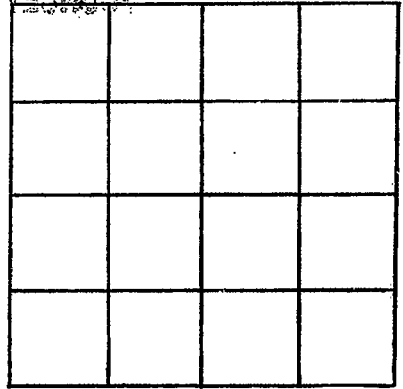

SECTION \_\_\_\_\_

Please indicate well location X.

ADDITIONAL INFORMATION

If more than one screen,  
show locations of each on sketch.