

MISSISSIPPI DEPARTMENT OF NATURAL RESOURCES

Bureau of Land and Water Resources

Southport Mall

BUD PENTON & SON  
WATER WELL SERVICE  
ROUTE 4 BOX 402  
CARRIERS, MS 39428  
PHONE 798-5324

BUD PENTON & SON  
WATER WELL SERVICE  
P.O. Box 10631  
CARRIERS, MISSISSIPPI 39209  
ROUTE 4 BOX 402  
PHONE 798-5324

DRILLERS LOG

Pearl River  
W 20065

3/15

1983

date well completed

firm name

Pearl River  
county well located

LANDOWNER: Eugen Meserold

description of formations encountered

from to

A.T. 15 Box 163 Poycogen

Red shale  
white sand  
blue shale  
Blue sand

0 11  
11 65  
65 400  
400 431

(mailing address)

WELL LOCATION:

sec 27 T 6 N R 17 E  
S W  
2 miles West of Poycogen  
(distance) (direction) (nearest town)

WELL PURPOSE: home  
(home, irrigation, municipal, industrial)

WELL COMPLETION DATA:

(1) diameter (inches) 2"  
(2) total depth (feet) 431  
(3) static water level (feet) 22 below above top of ground.

(4) casing PVC, 431  
(material) (depth)  
(size) if telescope see back.

(5) screen 2x10, 421  
(length) (depth to top)  
12, PVC  
(size) (material)

(6) pump no  
(HP) (yield gpm)  
(type power)

(7) electric log no  
(yes or no)

(organization running log)

(8) how well bottom plugged sand shale

DRILLERS REMARKS:


DEPT. OF NATURAL RESOURCES  
BUREAU OF LAND & WATER RESOURCES

APR 27 1983

RECEIVED

If well telescopes please sketch and show depths.

GROUND LEVEL

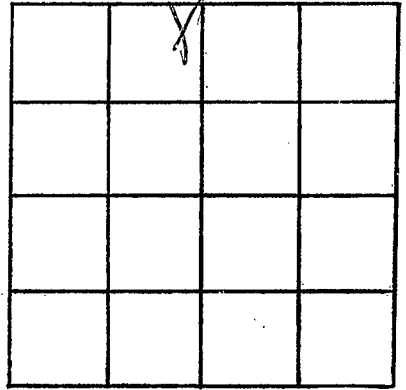

SECTION \_\_\_\_\_

Please indicate well location X.

ADDITIONAL INFORMATION

If more than one screen,  
show locations of each on sketch.