

MISSISSIPPI DEPARTMENT OF NATURAL RESOURCES

Bureau of Land and Water Resources

Southport Mall

P.O. Box 10631

Jackson, Mississippi 39209

WATER WELL DRILLERS LOG

Pearl River  
W 2060

6-1 1983 POUNCEY WATER WELL DRILLING Pearl River  
date well completed firm name county well located

LANDOWNER: Benson Hill  
RICHARD Lewis  
Cosmos  
(mailing address)

WELL LOCATION:  
sec. 3 T. 6 N. R. 17 E  
1 miles (distance) N (direction) of P. Cayman (nearest town)

WELL PURPOSE: Home Use  
(home, irrigation, municipal, industrial)

WELL COMPLETION DATA:


- (1) diameter (inches) 2
- (2) total depth (feet) 348
- (3) static water level (feet) 20 below above top of ground.
- (4) casing PVC, 338 (material) (depth)  
2 (size) if telescope see back.
- (5) screen 10, 338 (length) (depth to top)  
2 (size) PVC (material)
- (6) pump 3/4, 15 (HP) (yield gpm)  
AC 270 (type power)
- (7) electric log / (yes or no)  
(organization running log)
- (8) how well bottom plugged Sealed

description of formations encountered	from	to
<u>top</u>	<u>0</u>	<u>12</u>
<u>sd - 25' rocks</u>	<u>12</u>	<u>130</u>
<u>plm</u>		
<u>clay</u>	<u>120</u>	<u>286</u>
<u>sd - 1/2 to 6' sand</u>	<u>286</u>	<u>348</u>
<u>mid fast 15'</u>		

DRILLERS REMARKS:

If well telescopes please sketch and show depths.

GROUND LEVEL

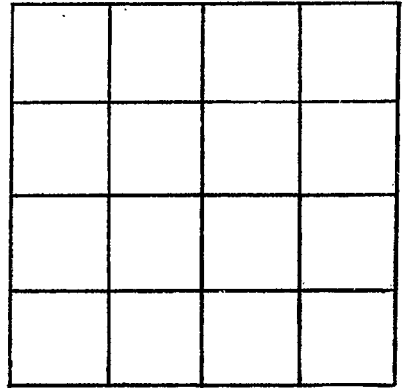

SECTION \_\_\_\_\_

Please indicate well location X.

ADDITIONAL INFORMATION

If more than one screen,  
show locations of each on sketch.