

MISSISSIPPI DEPARTMENT OF NATURAL RESOURCES

Bureau of Land and Water Resources

BUD PENTON & SON
WATER WELL SERVICE
ROUTE 4 BOX 402
CARRIERE, MS 39428
PHONE 798-5324

BUD PENTON & SON
WATER WELL SERVICE
ROUTE BOX
CARRIERE, MS 39428
PHONE 798-5324

WATER WELL DRILLERS LOG

Real River
W 2067

5/23

19 83

date well completed

firm name

Real River
county well located

LANDOWNER: Gene Watson

description of formations encountered

from

to

R.T. Po Box 93 2006

White Shell

0 12

East first payment
(mailing address)

White sand

15 60

Blue shale

60 285

Grey sand

285 310

WELL LOCATION:

sec 20 T 7 N R 17 E
S W
1/4 miles East of Carriere
(distance) (direction) (nearest town)

WELL PURPOSE: Drinking
(home, irrigation, municipal, industrial)

WELL COMPLETION DATA:

- (1) diameter (inches) 2"
- (2) total depth (feet) 310
- (3) static water level (feet) 21 below above top of ground.
- (4) casing pvc, 310,
(material) (depth)

_____ If telescope see back.
(size)

- (5) screen 10 ft, 300
(length) (depth to top)
- 10", pvc
(size) (material)

- (6) pump no
(HP) (yield gpm)

_____ (type power)

- (7) electric log no
(yes or no)

_____ (organization running log)

- (8) how well bottom plugged Sharp

DRILLERS REMARKS: no pump furnished


DEPT. OF NATURAL RESOURCES
BUREAU OF LAND & WATER RESOURCES

JUL 28 1983

RECEIVED

If well telescopes please sketch and show depths.

GROUND LEVEL

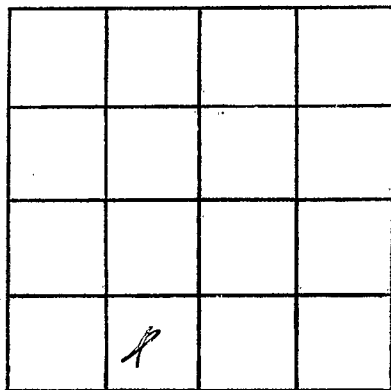

SECTION _____

Please indicate well location X.

ADDITIONAL INFORMATION

If more than one screen, show locations of each on sketch.