

**MISSISSIPPI DEPARTMENT OF NATURAL RESOURCES**  
**Bureau of Land and Water Resources**  
**Southport Mall**  
**P.O. Box 10631**  
**Jackson, Mississippi 39209**  
**WATER WELL DRILLERS LOG**

Pearl River  
W 2069

8-10-83 19 Walker's Welding and Repair Pearl River  
 date well completed firm name county well located

LANDOWNER:	description of formations encountered	from	to
Freddie Hartfield Rt 5 Box 558 Poplarville ms (mailing address)			
WELL LOCATION: sec. <u>10</u> T <u>7</u> N R <u>17</u> E S W  _____ miles _____ of _____ (distance) (direction) (nearest town)	Blue Shale	45	60
	Fine Sand	60	65
	Blue Shale	65	125
	Fine Sand	125	130
	Blue Shale	130	180
	Fine Sand	180	190
	Coarse Sand	190	207
	_____		
WELL PURPOSE: Home * (home, irrigation, municipal, industrial)			
WELL COMPLETION DATA:			
(1) diameter (inches) <u>2</u>			
(2) total depth (feet) <u>207</u>			
(3) static water level (feet) <u>119</u> <u>below</u> <u>above</u> top of ground.			
(4) casing <u>PVC</u> <u>197</u> (material) (depth)  _____ if telescope see back. (size)			
(5) screen <u>10</u> <u>197</u> (length) (depth to top)  <u>12</u> <u>PVC</u> (size) (material)			
(6) pump <u>1/2</u> <u>8</u> (HP) (yield gpm)  <u>Electric</u> (type power)			
(7) electric log <u>no</u> (yes or no)  _____ (organization running log)			
(8) how well bottom plugged _____ <u>Sand Shark</u>			
DRILLERS REMARKS:			


DEPT. OF NATURAL RESOURCES  
 BUREAU OF LAND & WATER RESOURCES

SEP - 8 1983

**RECEIVED**

If well telescopes please sketch and show depths.

GROUND LEVEL

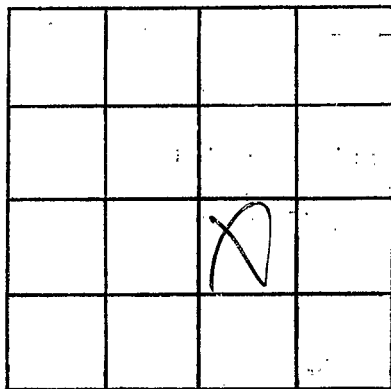

SECTION \_\_\_\_\_

Please indicate well location X.

ADDITIONAL INFORMATION

If more than one screen,  
show locations of each on sketch.