

Pearl River
WY 2070

MISSISSIPPI DEPARTMENT OF NATURAL RESOURCES

Bureau of Land and Water Resources

Southport Mall

P.O. Box 10631

Jackson, Mississippi 39209

WATER WELL DRILLERS LOG

POUNCEY WATER WELL DRILLING, Pearl River

7-7 1983 date well completed
firm name
county well located

LANDOWNER: James McCombs
Richardson Town

description of formations encountered

from to

(mailing address)

WELL LOCATION:

sec. 3 T 6 N R 17 E
S W
1 1/2 miles W of Pouncey
(distance) (direction) (nearest town)

WELL PURPOSE: Home
(home, irrigation, municipal, industrial)

WELL COMPLETION DATA:

- (1) diameter (inches) 2" 350
- (2) total depth (feet) 350
- (3) static water level (feet) 20 below top of ground
- (4) casing PVC 340 (material) (depth)
2 (size) if telescope see back.
- (5) screen 10 340 (length) (depth to top)
2 (size) PVC (material)
- (6) pump 1/2 (HP) 1 (yield gpm)
AC (type power)
- (7) electric log (yes or no)
- (8) how well bottom plugged Seal

Top 0 10
sd. 10 49
Clay 49 302
Silt. 302 318
fair to good sd. 318 334
Mostly good sd. 334 350

DEPT. OF NATURAL RESOURCES
BUREAU OF LAND & WATER RESOURCES


AUG 26 1983

DRILLERS REMARKS:

RECEIVED

If well telescopes please sketch and show depths.

GROUND LEVEL

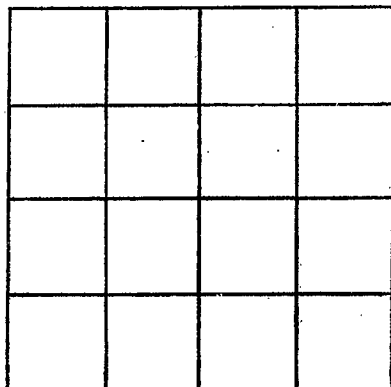

SECTION _____

Please indicate well location X.

ADDITIONAL INFORMATION

If more than one screen, show locations of each on sketch.