

MISSISSIPPI DEPARTMENT OF NATURAL RESOURCES

Bureau of Land and Water Resources

Southport Mall

P.O. Box 10631

Jackson, Mississippi 39209

WATER WELL DRILLERS LOG

Pearl River
W 2074

9-25-83

19

Walker's Welding and Repair

Pearl River

date well completed

firm name

county well located

LANDOWNER: Doris Naquin Horseshoe Lane Picayune Ms	description of formations encountered	from	to
(mailing address)	Red Clay	0	10
	Fine Sand	10	20
	Blue Shale	20	35
	Fine Sand	35	50
	Coarse Sand	50	72
WELL LOCATION: sec. <u>7</u> T. <u>7</u> N. R. <u>18</u> E S W <u>2</u> miles <u>W</u> of <u>Picayune</u> (distance) (direction) (nearest town)			
WELL PURPOSE: <u>Home</u> (home, irrigation, municipal, industrial)			
WELL COMPLETION DATA:			
(1) diameter (inches) <u>4</u>			
(2) total depth (feet) <u>72</u>			
(3) static water level (feet) <u>10</u> below top of ground. above			
(4) casing <u>PVC</u> , <u>62</u> (material) (depth) <u> </u> if telescope see back. (size)			
(5) screen <u>10'</u> , <u>62</u> (length) (depth to top) <u>12</u> , <u>PVC</u> (size) (material)			
(6) pump <u>1</u> , <u>20</u> (HP) (yield gpm)			
Electric (type power)			
(7) electric log <u>No</u> (yes or no) <u> </u> (organization running log)			
(8) how well bottom plugged <u>Sand Shark</u>			
DRILLERS REMARKS:			


DEPT. OF NATURAL RESOURCES
BUREAU OF LAND & WATER RESOURCES

OCT 10 1983

RECEIVED

If well telescopes please sketch and show depths.

GROUND LEVEL

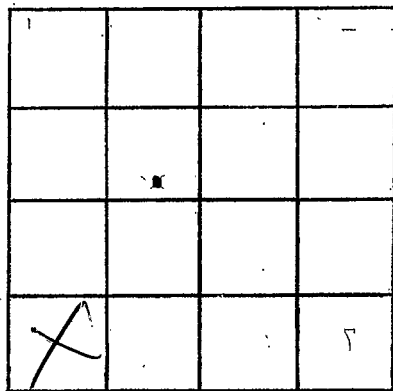

SECTION _____

Please indicate well location X.

ADDITIONAL INFORMATION

If more than one screen,
show locations of each on sketch.