

MISSISSIPPI DEPARTMENT OF NATURAL RESOURCES

Bureau of Land and Water Resources

Southport Mall

P.O. Box 10631

Jackson, Mississippi 39209

WATER WELL DRILLERS LOG

Paul Rivers  
W 2075

Dec 18 - 83 19 Walker Welding Pearl River  
 date well completed firm name county well located

LANDOWNER: Pete Clark  
R1 Cummins Mill  
 (mailing address)

description of formations encountered	from	to
<u>white shale</u>	<u>0</u>	<u>15</u>
<u>sand &amp; gravel</u>	<u>15</u>	<u>54</u>
<u>blue shale</u>	<u>54</u>	<u>200</u>
<u>blue sand</u>	<u>200</u>	<u>240</u>

WELL LOCATION:  
 sec. 17 T. 6 S. R. 17 E. W.  
Mill Creek Corn  
 (distance) miles (direction) of (nearest town)

WELL PURPOSE: Home  
 (home, irrigation, municipal, industrial)

WELL COMPLETION DATA:

- (1) diameter (inches) 2"
- (2) total depth (feet) 240'
- (3) static water level (feet) 90 below top of ground.
- (4) casing PVC, 230  
 (material) (depth)  
 (size) if telescope see back.
- (5) screen 10', 230'  
 (length) (depth to top)  
10, PVC  
 (size) (material)
- (6) pump 1, 8  
 (HP) (yield gpm)  
Elec  
 (type power)
- (7) electric log                       
 (yes or no)  
 (organization running log)
- (8) how well bottom plugged Sand  
shale

DRILLERS REMARKS:


DEPT. OF NATURAL RESOURCES  
 BUREAU OF LAND & WATER RESOURCES

DEC 29 1983

RECEIVED

If well telescopes please sketch and show depths.

GROUND LEVEL

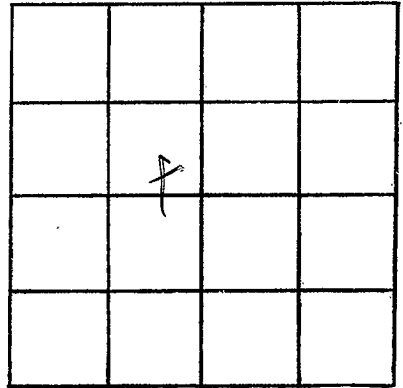

SECTION \_\_\_\_\_

Please indicate well location X.

ADDITIONAL INFORMATION

If more than one screen,  
show locations of each on sketch.