

MISSISSIPPI DEPARTMENT OF NATURAL RESOURCES

Bureau of Land and Water Resources

Southport Mall

P.O. Box 10631

Jackson, Mississippi 39209

WATER WELL DRILLERS LOG

Pearl River  
W 2077

POUNCEY WATER WELL DRILLING Pearl River

12-20 1983  
date well completed

firm name

county well located

LANDOWNER: Arno Stockstill

Burnt Bridge Rd.

Preogon  
(mailing address)

WELL LOCATION:

sec. 6 T. 6 N R. 17 E  
CS CW  
1 1/2 miles SE of Industree  
(distance) (direction) (nearest town)  
Choud

WELL PURPOSE: Home  
(home, irrigation, municipal, industrial)

WELL COMPLETION DATA:

- (1) diameter (inches) 2
- (2) total depth (feet) 320
- (3) static water level (feet) 13 below above top of ground.
- (4) casing PVC 3/10  
(material) (depth)  
2 if telescope see back.  
(size)
- (5) screen 10 3/10  
(length) (depth to top)  
2 PVC  
(size) (material)
- (6) pump 1 20  
(HP) (yield gpm)  
AC  
(type power)
- (7) electric log NO  
(yes or no)

(organization running log)

(8) how well bottom plugged Sealed

DRILLERS REMARKS:

description of formations encountered

from

to


<u>Top</u>	<u>0</u>	<u>12</u>
<u>sd &amp; gravel</u>	<u>12</u>	<u>63</u>
<u>Clay</u>	<u>63</u>	<u>92</u>
<u>slt to fine sd.</u>	<u>92</u>	<u>170</u>
<u>Clay slt sdy grs</u>	<u>170</u>	<u>275</u>
<u>fine to fair sd.</u>	<u>275</u>	<u>320</u>

DEPT. OF NATURAL RESOURCES  
BUREAU OF LAND & WATER RESOURCES

JAN 26 1984  
RECEIVED

If well telescopes please sketch and show depths.

GROUND LEVEL

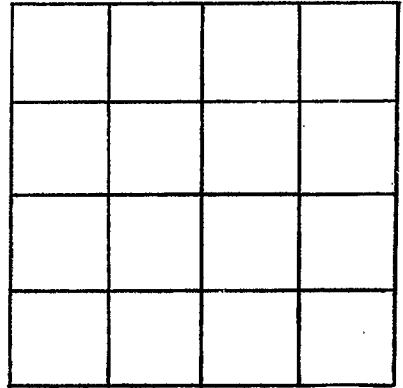

SECTION \_\_\_\_\_

Please indicate well location X.

ADDITIONAL INFORMATION

If more than one screen,  
show locations of each on sketch.