

MISSISSIPPI DEPARTMENT OF NATURAL RESOURCES

Bureau of Land and Water Resources

Southport Mall

P.O. Box 10631

Jackson, Mississippi 39209

WATER WELL DRILLERS LOG

Paul River
W 2078

8-30-83 **POUNCEY WATER WELL DRILLING** *Paul River*
date well completed firm name county well located

LANDOWNER: *Chris Apter*
Hippo - Rd.
(mailing address)

WELL LOCATION:
sec. 18 T 7 N R 17 E
1/2 City Limits
(distance) miles (direction) of (nearest town)
at Air Port

WELL PURPOSE: *Home*
(home, irrigation, municipal, industrial)

- WELL COMPLETION DATA:
- (1) diameter (inches) 2
 - (2) total depth (feet) 420
 - (3) static water level (feet) 30 below top of ground
 - (4) casing PVC 410
(material) (depth)
2 if telescope see back.
(size)
 - (5) screen 10 410
(length) (depth to top)
2 PVC
(size) (material)
 - (6) pump 1 15
(HP) (yield gpm)
AC
(type power)
 - (7) electric log No
(yes or no)
 - (8) how well bottom plugged *Sealed BWT*

description of formations encountered	from	to
<i>Top 5' Clay</i>	<i>0</i>	<i>30</i>
<i>SD 5' Big Big gravel - made of gell.</i>	<i>30</i>	<i>110</i>
<i>Clay - Blue stringy mostly soft - some HD - wood York -</i>	<i>110</i>	<i>340</i>
<i>SD fine to fair med fine</i>	<i>340</i>	<i>380</i>
<i>Mostly good med SD</i>	<i>380</i>	<i>420</i>


DRILLERS REMARKS:

DEPT. OF NATURAL RESOURCES
BUREAU OF LAND & WATER RESOURCES

JAN 26 1984
RECEIVED

If well telescopes please sketch and show depths.

GROUND LEVEL

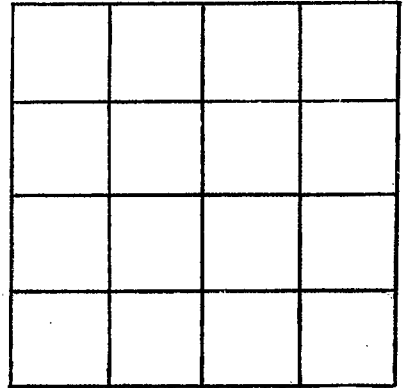

SECTION _____

Please indicate well location X.

ADDITIONAL INFORMATION

If more than one screen,
show locations of each on sketch.