

Pearl River  
WATER

MISSISSIPPI  
BOARD OF WATER COMMISSIONERS  
416 North State Street  
Jackson, Mississippi 39201

WATER WELL DRILLERS LOG

19 Penton Well Service firm name Pearl River county well located  
date well completed

LANDOWNER: David Lossett  
Rt. 4  
Picayune MS.  
(mailing address)

description of formations encountered	from	to
Surface Clay	0	40
sand	40	100
Clay	100	380
sand	380	450

WELL LOCATION:  
sec. 7 T. 6 N. R. 17 E  
S W  
1/2 miles W of Picayune  
(distance) (direction) (nearest town)

WELL PURPOSE: Home  
(home, irrigation, municipal, industrial)

- WELL COMPLETION DATA:
- (1) diameter (inches) 2
  - (2) total depth (feet) 450
  - (3) static water level (feet) 30 below above top of ground.
  - (4) casing PVC 440  
(material) (depth)  
2 if telescope see back.  
(size)
  - (5) screen 10' 440  
(length) (depth to top)  
2 PVC  
(size) (material)
  - (6) pump 1/2 15  
(HP) (yield gpm)  
Elec.  
(type power)
  - (7) electric log NO  
(yes or no)  
(organization running log)
  - (8) how well bottom plugged B.W. Value


DRILLERS REMARKS:

DEPT. OF NATURAL RESOURCES  
BUREAU OF LAND & WATER RESOURCES  
MAY 30 1994

RECEIVED

If well telescopes please sketch and show depths.

GROUND LEVEL

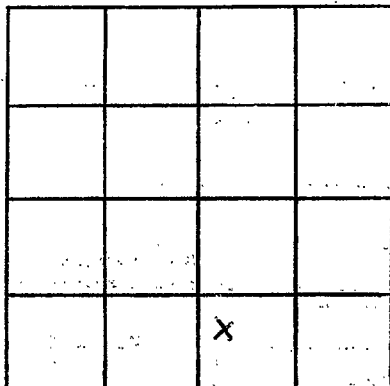

SECTION 7

Please indicate well location X.

ADDITIONAL INFORMATION

If more than one screen, show locations of each on sketch.