

Pearl River
W 2080

MISSISSIPPI
 BOARD OF WATER COMMISSIONERS
 416 North State Street
 Jackson, Mississippi 39201

WATER WELL DRILLERS LOG

4-30 19
 date well completed

84 Penton Well Service
 firm name

Pearl River
 county well located

LANDOWNER: Curtis McCarty

description of formations encountered	from	to
<u>surface clay</u>	<u>0</u>	<u>40</u>
<u>sand</u>	<u>40</u>	<u>110</u>
<u>clay</u>	<u>110</u>	<u>180</u>
<u>silt</u>	<u>180</u>	<u>260</u>
<u>clay</u>	<u>260</u>	<u>410</u>
<u>sand</u>	<u>410</u>	<u>480</u>

Nicholson MS
 (mailing address)

WELL LOCATION:
 sec. 2 T. 7 N. R. 17 E
1/2 miles S of Nicholson
 (distance) (direction) (nearest town)

WELL PURPOSE: Home
 (home, irrigation, municipal, industrial)

- WELL COMPLETION DATA:
- (1) diameter (inches) 2
 - (2) total depth (feet) 480
 - (3) static water level (feet) 250 below top of ground
 - (4) casing PVC 470
 (material) (depth)
 - 2 if telescope see back.
 (size)
 - (5) screen 10' 470
 (length) (depth to top)
 - 2 PVC
 (size) (material)
 - (6) pump 1/2 15
 (HP) (yield gpm)
 - Flec.
 (type power)
 - (7) electric log No
 (yes or no)
 - (organization running log)
 - (8) how well bottom plugged B.W. Valve

DEPT. OF NATURAL RESOURCES
 BUREAU OF LAND & WATER RESOURCES


MAY 30 1984

RECEIVED

DRILLERS REMARKS:

If well telescopes please sketch and show depths.

GROUND LEVEL

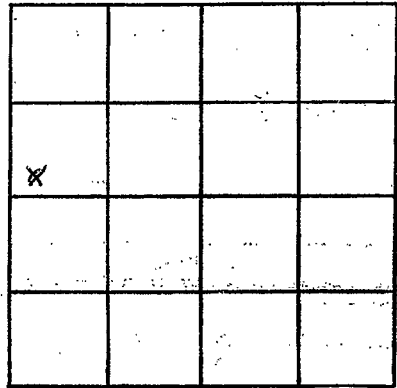

SECTION 2

Please indicate well location X.

ADDITIONAL INFORMATION

If more than one screen,
show locations of each on sketch.