

MISSISSIPPI DEPARTMENT OF NATURAL RESOURCES

Bureau of Land and Water Resources

Southport Mall

P.O. Box 10631

Jackson, Mississippi 39209

WATER WELL DRILLERS LOG

~~W-195~~ W-081
 PEARL RIVER
 5-15-84

5-15 1984 date well completed
 Joe Wilkerson firm name
 Pearl River county well located

LANDOWNER: Wayne Rivers
2445 Jackson Hwy
Rd. Prichard, MS
 (mailing address)

description of formations encountered	from	to
yellow clay	0	21
sand + gravel	21	80
clay + sand	80	130
clay blue	130	150
sand	150	230

WELL LOCATION:
 sec. 17 T. 7 N. R. 17 E.
S W
3 miles W of Nicholson
 (distance) (direction) (nearest town)

WELL PURPOSE: Home
 (home) irrigation, municipal, industrial

WELL COMPLETION DATA:

(1) diameter (inches) 2"

(2) total depth (feet) 230'

(3) static water level (feet) 22 ^{below} _{above} top of ground.

(4) casing 5640PK, 200,
 (material) (depth)

 if telescope see back.
 (size)

(5) screen 10', 230
 (length) (depth to top)

1, 5640PK
 (size) (material)

(6) pump 1hp, 9 GPM
 (HP) (yield gpm)

3/4
 (type power)

(7) electric log No
 (yes or no)

 (organization running log)


(8) how well bottom plugged 2 BWD

DEPT. OF NATURAL RESOURCES
 BUREAU OF LAND & WATER RESOURCES
 JUN 15 1984
RECEIVED

DRILLERS REMARKS:

If well telescopes please sketch and show depths.

GROUND LEVEL

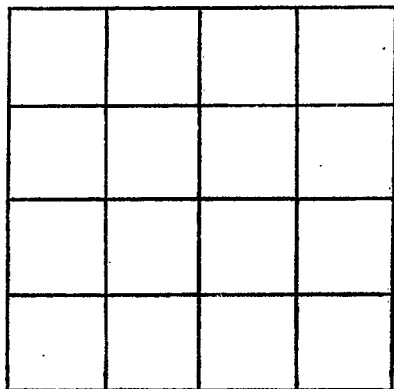

SECTION _____

Please indicate well location X.

ADDITIONAL INFORMATION

If more than one screen,
show locations of each on sketch.