

Pearl River  
W 2022

MISSISSIPPI  
 BOARD OF WATER COMMISSIONERS  
 416 North State Street  
 Jackson, Mississippi 39201

WATER WELL DRILLERS LOG

5-5  
 date well completed

1984 Penton Well Service  
 firm name

Pearl River  
 county well located

LANDOWNER: Tommy Henry  
Rt. 4  
Picayune MS  
 (mailing address)  
 WELL LOCATION:  
 sec. 37 T. 6 N. R. 17 E.  
 S W  
1/2 miles S of Picayune  
 (distance) (direction) (nearest town)

description of formations encountered	from	to
<u>surface clay</u>	<u>0</u>	<u>30</u>
<u>sand</u>	<u>30</u>	<u>110</u>
<u>clay</u>	<u>110</u>	<u>400</u>
<u>sand</u>	<u>400</u>	<u>490</u>

WELL PURPOSE: Home  
 (home, irrigation, municipal, industrial)

WELL COMPLETION DATA:

- (1) diameter (inches) 2
- (2) total depth (feet) 490
- (3) static water level (feet) 20 below above top of ground.
- (4) casing PVC 480  
 (material) (depth)  
2 if telescope see back.  
 (size)
- (5) screen 10' 480  
 (length) (depth to top)  
2 PVC  
 (size) (material)
- (6) pump 1/2 15  
 (HP) (yield gpm)  
Elec.  
 (type power)
- (7) electric log NO  
 (yes or no)

(organization running log)

(8) how well bottom plugged B.W. Value

DRILLERS REMARKS:


DEPT. OF NATURAL RESOURCES  
 BUREAU OF LAND & WATER RESOURCES

MAY 30 1984

RECEIVED

If well telescopes please sketch and show depths.

GROUND LEVEL

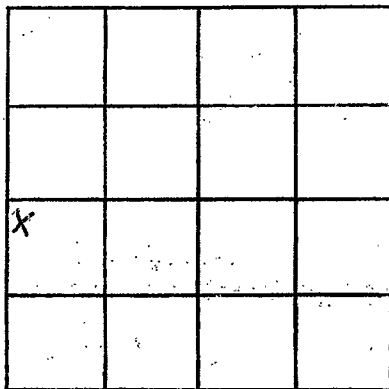

SECTION 27

Please indicate well location X.

ADDITIONAL INFORMATION

If more than one screen, show locations of each on sketch.