

MISSISSIPPI DEPARTMENT OF NATURAL RESOURCES

Bureau of Land and Water Resources

Southport Mall

P.O. Box 10631

Jackson, Mississippi 39209

WATER WELL DRILLERS LOG

Paul River
 W 0083

5-28-84
 date well completed

POUNCEY WATER WELL DRILLING
 firm name

Paul River
 county well located

LANDOWNER: *Horstmann System*
Prayon
 (mailing address)

| description of formations encountered | from | to |
|---------------------------------------|-----------|-----------|
| <i>TOP</i> | <i>0</i> | <i>12</i> |
| <i>50' gravel</i> | <i>12</i> | <i>64</i> |

WELL LOCATION:
 sec 10 T 6 N R 17 E
 City S W
 (distance) miles (direction) of (nearest town)

WELL PURPOSE: *for heat*
 (home, irrigation, municipal, industrial)

- WELL COMPLETION DATA:
- (1) diameter (inches) 2
 - (2) total depth (feet) 64
 - (3) static water level (feet) 30 below top of ground
 - (4) casing PVC 54
 (material) (depth)
 - (size) 2 if telescope see back.
 - (5) screen 10 54
 (length) (depth to top)
 - (size) 2 (material) PVC
 - (6) pump 1/2 12
 (HP) (yield gpm)
 - (type power) AC
 - (7) electric log _____
 (yes or no)

(organization running log) _____
 (8) how well bottom plugged *Sealed*

DRILLERS REMARKS: _____


DEPT. OF NATURAL RESOURCES
 BUREAU OF LAND & WATER RESOURCES

SEP 10 1984

RECEIVED

If well telescopes please
sketch and show depths.

GROUND LEVEL

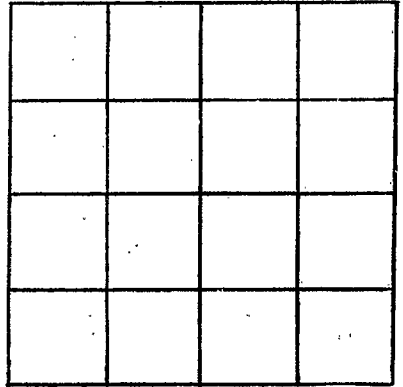

SECTION _____

Please indicate well location X.

ADDITIONAL INFORMATION

If more than one screen,
show locations of each on sketch.