

MISSISSIPPI DEPARTMENT OF NATURAL RESOURCES

Bureau of Land and Water Resources

Southport Mall

P.O. Box 10631

Jackson, Mississippi 39209

WATER WELL DRILLERS LOG

PEARL RIVER  
W 2084

*Peston & Son* *Pearl River*

19 \_\_\_\_\_ date well completed

\_\_\_\_\_ firm name

\_\_\_\_\_ county well located

LANDOWNER: *Harry Lee*  
*95-Rowhead Drive*  
*Picayune Miss.*  
(mailing address)

description of formations encountered	from	to
	<i>Red shale</i>	<i>0</i>
<i>White sand</i>	<i>18</i>	<i>70</i>
<i>Blue shale</i>	<i>70</i>	<i>375</i>
<i>Gray sand</i>	<i>375</i>	<i>415</i>

WELL LOCATION:  
sec. *31* T. *7* N R. *18* E  
S W  
*4* miles (distance) *W* (direction) *Picayune* (nearest town)

WELL PURPOSE: *Home*  
(home, irrigation, municipal, industrial)

WELL COMPLETION DATA:

- (1) diameter (inches) *2"*
- (2) total depth (feet) *415*
- (3) static water level (feet) *21* below top of ground.
- (4) casing *PVC* *415*  
(material) (depth)
- (size) if telescope see back.
- (5) screen *2x10* *405*  
(length) (depth to top)
- 12* *PVC*  
(size) (material)
- (6) pump *1/2* *460*  
(HP) (yield gpm)
- (type power)
- (7) electric log *no*  
(yes or no)

(organization running log)

(8) how well bottom plugged *Shark*

DRILLERS REMARKS:


DEPT. OF NATURAL RESOURCES  
BUREAU OF LAND & WATER RESOURCES

JUL 19 1984

RECEIVED

If well telescopes please sketch and show depths.

GROUND LEVEL

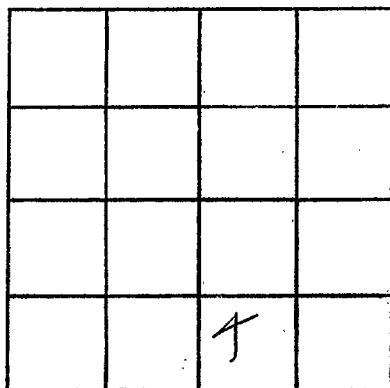

SECTION \_\_\_\_\_

Please indicate well location X.

ADDITIONAL INFORMATION

If more than one screen, show locations of each on sketch.