

MISSISSIPPI DEPARTMENT OF NATURAL RESOURCES

Bureau of Land and Water Resources

Southport Mall

P.O. Box 10631

Jackson, Mississippi 39209

WATER WELL DRILLERS LOG

Paul River  
W 2085

11/29 19 84 Bud Porter Water Pearl River  
date well completed well name county well located

LANDOWNER: <u>Jerry Smith</u>	description of formations encountered	from	to
(mailing address)			
<u>R.T. 2 Box Piqueno Miss.</u>	<u>Red shale</u>	<u>0</u>	<u>10</u>
	<u>white sand</u>	<u>10</u>	<u>30</u>
	<u>Blue shale</u>	<u>30</u>	<u>320</u>
	<u>gray sand</u>	<u>320</u>	<u>428</u>

WELL LOCATION:  
sec. 29 T 5 N R 17 E  
5 miles W of Piqueno  
(distance) (direction) (nearest town)

WELL PURPOSE: home  
(home, irrigation, municipal, industrial)

- WELL COMPLETION DATA:
- (1) diameter (inches) 2 1/2
  - (2) total depth (feet) 428
  - (3) static water level (feet) 30 below top of ground.
  - (4) casing PVC, 428,  
(material) (depth)
  - (size) If telescope see back.
  - (5) screen 2x10, 418  
(length) (depth to top)
  - 10, PVC  
(size) (material)
  - (6) pump 1/2, 450  
(HP) (yield gpm)
  - Elect  
(type power)
  - (7) electric log NO  
(yes or no)

(organization running log)  
(8) how well bottom plugged sand  
sharp


DRILLERS REMARKS:

DEPT. OF NATURAL RESOURCES  
BUREAU OF LAND & WATER RESOURCES

DEC 4 1984  
RECEIVED

If well telescopes please sketch and show depths.

GROUND LEVEL

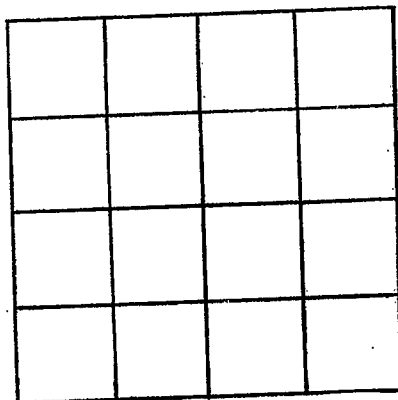

SECTION \_\_\_\_\_

Please indicate well location X.

ADDITIONAL INFORMATION

Lined area for additional information.

If more than one screen, show locations of each on sketch.