

MISSISSIPPI DEPARTMENT OF NATURAL RESOURCES

Bureau of Land and Water Resources

Southport Mall

P.O. Box 10631

Jackson, Mississippi 39209

WATER WELL DRILLERS LOG

PEARL RIVER  
W 2088

6-14 1985 WALKERS WELDING PR  
date well completed firm name county well located

LANDOWNER: <u>Rickey Dagle</u>	description of formations encountered	from	to
<u>Picayune, MS.</u> (mailing address)	<u>CLAY</u>	<u>0</u>	<u>17</u>
	<u>SAND &amp; GRAVEL</u>	<u>17</u>	<u>90</u>
	<u>CLAY</u>	<u>90</u>	<u>230</u>
	<u>SAND</u>	<u>230</u>	<u>235</u>
	<u>CLAY</u>	<u>235</u>	<u>241</u>
	<u>SAND</u>	<u>241</u>	<u>246</u>
	<u>CLAY</u>	<u>246</u>	<u>390</u>
	<u>SAND</u>	<u>390</u>	<u>435</u>
WELL LOCATION: sec. <u>27 T. 6 N. R. 17 E.</u> <u>S</u> <u>S</u> <u>W</u> <u>3</u> miles <u>S</u> of <u>Picayune</u> (distance) (direction) (nearest town)			
WELL PURPOSE: <u>HOME</u> (home, irrigation, municipal, industrial)			
WELL COMPLETION DATA:			
(1) diameter (inches) <u>2</u>			
(2) total depth (feet) <u>435</u>			
(3) static water level (feet) <u>16</u> below top of ground.			
(4) casing <u>PVC</u> , <u>435</u> (material) (depth)			
<u>        </u> if telescope see back. (size)			
(5) screen <u>15</u> , <u>420</u> (length) (depth to top)			
<u>2"</u> , <u>PVC</u> (size) (material)			
(6) pump <u>        </u> <u>        </u> (HP) (yield gpm)			
<u>        </u> (type power)			
(7) electric log <u>        </u> (yes or no)			
<u>        </u> (organization running log)			
(8) how well bottom plugged <u>Sand shank</u>			

RECEIVED


JUN 25 1985

Department of Natural Resources  
Bureau of Land & Water Resources

DRILLERS REMARKS:

If well telescopes please sketch and show depths.

GROUND LEVEL

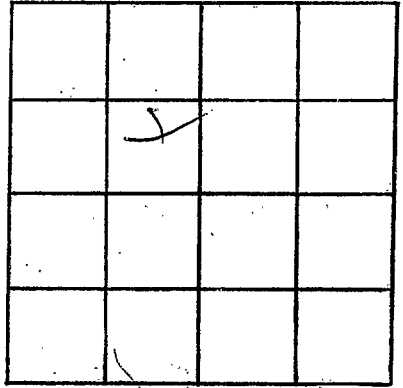

SECTION \_\_\_\_\_

Please indicate well location X.

ADDITIONAL INFORMATION

If more than one screen,  
show locations of each on sketch.