

## MISSISSIPPI DEPARTMENT OF NATURAL RESOURCES

Bureau of Land and Water Resources

Southport Mall

P.O. Box 10631

Jackson, Mississippi 39209

## WATER WELL DRILLERS LOG

10/8  
date well completed

19

85 PENTON & SON  
firm namePearl River  
county well located

LANDOWNER:

Dondy Elect

description of formations  
encountered

from

to

DWH North Picayune

white shale

0 50

sand

50 60

Blue shale

60 275

Grey sand

275 294

(mailing address)

WELL LOCATION:

sec. 18 T. 6 N R. 17 E  
S W1/4 miles N of Picayune  
(distance) (direction) (nearest town)

WELL PURPOSE:

Elect. power  
(home, irrigation, municipal, industrial)

WELL COMPLETION DATA:

- (1) diameter (inches) 2"
- (2) total depth (feet) 294
- (3) static water level (feet) 8 below above ground.

- (4) casing PVC, 294,  
(material) (depth)

710 If telescope see back.  
(size)

- (5) screen 2x16, 284  
(length) (depth to top)

10, PVC  
(size) (material)

- (6) pump 710  
(HP) (yield gpm)


(type power)

- (7) electric log 710  
(yes or no)

(organization running log)

- (8) how well bottom plugged - good


DRILLERS REMARKS:

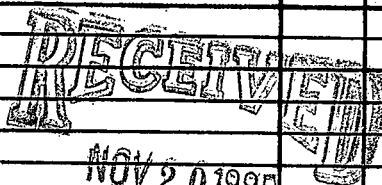50  
Pump furnished

Department of Natural Resources  
Bureau of Land & Water Resources

If well telescopes please  
sketch and show depths.

GROUND LEVEL

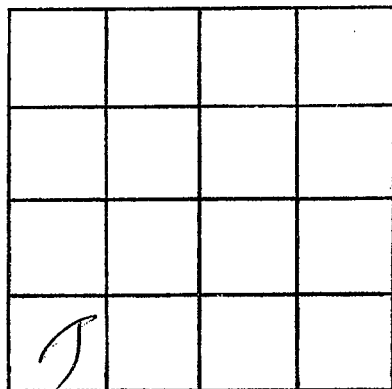

SECTION \_\_\_\_\_

Please indicate well location X.

ADDITIONAL INFORMATION

If more than one screen,  
show locations of each on sketch.