

MISSISSIPPI DEPARTMENT OF NATURAL RESOURCES

Bureau of Land and Water Resources

Southport Mall

P.O. Box 10631

Jackson, Mississippi 39209

WATER WELL DRILLERS LOG

PEARL RIVER  
W 2093

1-3 1986 PENTON WELL SERV. PEARL RIVER  
date well completed firm name county well located

LANDOWNER: WENDELL MOODY  
(WOOD TREATING) P.O. BOX  
? PICAYUNE MS.  
(mailing address)

description of formations encountered	from	to
CLAY	0	28
SAND	28	40

WELL LOCATION:  
sec 15 T. 6 S. R. 17 W.  
0 miles of PICAYUNE  
(distance) (direction) (nearest town)

WELL PURPOSE: TEST WELL  
(home, irrigation, municipal, industrial)

- WELL COMPLETION DATA:
- (1) diameter (inches) 2"
  - (2) total depth (feet) 40'
  - (3) static water level (feet) 18' below top of ground.
  - (4) casing PVC 30' (material) (depth)  
2" (size) if telescope see back.
  - (5) screen 10' 30' (length) (depth to top)  
2" (size) PVC (material)
  - (6) pump (HP) (yield gpm)  
(type power)
  - (7) electric log No (yes or no)  
(organization running log)
  - (8) how well bottom plugged B.W.


DRILLERS REMARKS: TEST WELL

RECEIVED  
JAN 30 1986

Department of Natural Resources  
Bureau of Land & Water Resources

If well telescopes please sketch and show depths.

GROUND LEVEL

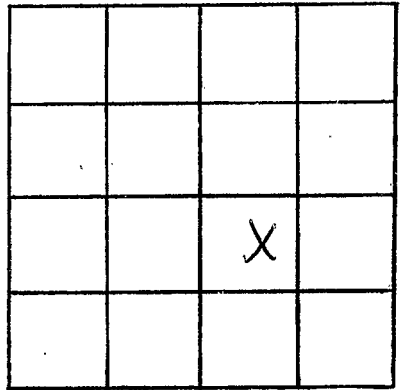

SECTION 15

Please indicate well location X.

ADDITIONAL INFORMATION

If more than one screen,  
show locations of each on sketch.