

MISSISSIPPI DEPARTMENT OF NATURAL RESOURCES

Bureau of Land and Water Resources

Southport Mall

P.O. Box 10631

Jackson, Mississippi 39209

WATER WELL DRILLERS LOG

Pearl River
W 2074

1/2 1986
date well completed

RUD PENTON & SONS Pearl River
Water Well Service county well located

LANDOWNER: 2 U Owens
254.43 north
(mailing address)

Rt. 4, Box 402
Pearl River, Mississippi 39226
Phone 601 - 798-5324

from	to
0	175
0	60
60	175
175	230

Red shale
Blue shale
gray sand

WELL LOCATION:
sec. 7 T. 7 N. R. 17 E
S. W.
3 miles NW of Piedmont
(distance) (direction) (nearest town)

WELL PURPOSE: home
(home, irrigation, municipal, industrial)


WELL COMPLETION DATA:

- (1) diameter (inches) 2"
- (2) total depth (feet) 230
- (3) static water level (feet) 40 below
top of ground. ~~above~~
- (4) casing PVC, 230,
(material) (depth)
210 if telescope see back.
(size)
- (5) screen 10, 220
(length) (depth to top)
10, PVC
(size) (material)
- (6) pump 1, 650
(HP) (yield gpm)
Cent.
(type power)
- (7) electric log no
(yes or no)

(organization running log)

(8) how well bottom plugged sand
Mark

DRILLERS REMARKS:

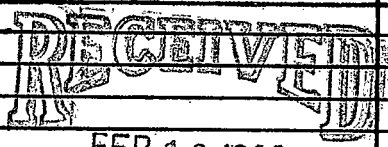

FEB 12 1986

Department of Natural Resources
Bureau of Land & Water Resources

If well telescopes please sketch and show depths.

GROUND LEVEL

7			

SECTION _____

Please indicate well location X.

ADDITIONAL INFORMATION

If more than one screen,
show locations of each on sketch.