

MISSISSIPPI DEPARTMENT OF NATURAL RESOURCES

Bureau of Land and Water Resources

Southport Mall

P.O. Box 10631

Jackson, Mississippi 39209

WATER WELL DRILLERS LOG

PEARL RIVER
WOODRIDGE

3-11-86 19 POUNCEY WATER WELL DRILLING Pearl River
date well completed firm name county well located

LANDOWNER: Del Varnock
Pick City

description of formations encountered from to

(mailing address)

WELL LOCATION:


sec. 2 T. 6 N. R. 17 E
1/2 miles N of Hy 43 rd
(distance) (direction) (nearest town)

TOP	0	4
SD gravel	8	28
clay	28	51
Hy 43 rd Hill Brown Str.	51	78
Clay Hill Bally	78	308
SD	308	352

WELL PURPOSE: Residential
(home, irrigation, municipal, industrial)

WELL COMPLETION DATA:

- (1) diameter (inches) 2
- (2) total depth (feet) 352
- (3) static water level (feet) 35 below above top of ground.
- (4) casing PVC 3/4"
(material) (depth)
2 if telescope see back.
(size)
- (5) screen 10 3/4"
(length) (depth to top)
2 PVC
(size) (material)
- (6) pump 1 18
(HP) (yield gpm)
AL
(type power)
- (7) electric log (yes or no)
(organization running log)
- (8) how well bottom plugged Sealed

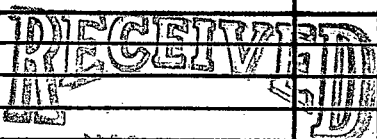


MAR 9 1986

DRILLERS REMARKS: Temporary well - used care
HT

DEPARTMENT OF NATURAL RESOURCES
BUREAU OF LAND AND WATER RESOURCES

If well telescopes please sketch and show depths.

GROUND LEVEL

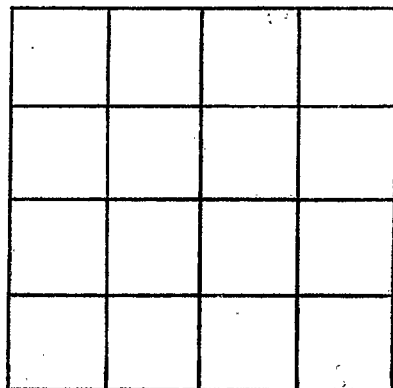

SECTION _____

Please indicate well location X.

ADDITIONAL INFORMATION

If more than one screen,
show locations of each on sketch.