

MISSISSIPPI DEPARTMENT OF NATURAL RESOURCES

Bureau of Land and Water Resources

Southport Mall

P.O. Box 10631

Jackson, Mississippi 39209

WATER WELL DRILLERS LOG

Pearl River
Walker

March 11 1986 Walker Welding Pearl River
date well completed firm name county well located

LANDOWNER: Mike Stockstill
Rt. 2 Picayune 798 - 7798

description of formations encountered from to

Clay 0 5
Sand and Gravel 5 54

(mailing address)

WELL LOCATION:

sec. 12 T. 76 N. R. 17 E.
3 miles West of Picayune
(distance) (direction) (nearest town)

WELL PURPOSE: Home
(home, irrigation, municipal, industrial)


WELL COMPLETION DATA:

- (1) diameter (inches) 2"
- (2) total depth (feet) 54'
- (3) static water level (feet) 12 below above top of ground.
- (4) casing PVC 44'
(material) (depth)
 if telescope see back.
(size)
- (5) screen 10' 44'
(length) (depth to top)
#12 Slotted
(size) (material)
- (6) pump 1/2 5
(HP) (yield gpm)
Electric
(type power)
- (7) electric log
(yes or no)

(organization running log)

(8) how well bottom plugged Sand Shark

DRILLERS REMARKS:

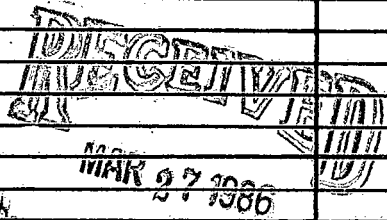

Department of Natural Resources
Bureau of Land and Water Resources

If well telescopes please sketch and show depths.

GROUND LEVEL

		X	
			SE

SECTION _____

Please indicate well location X.

ADDITIONAL INFORMATION

If more than one screen, show locations of each on sketch.