

PEARL RIVER  
W 2098

MISSISSIPPI DEPARTMENT OF NATURAL RESOURCES  
Bureau of Land and Water Resources  
Southport Mall  
P.O. Box 10631  
Jackson, Mississippi 39209  
WATER WELL DRILLERS LOG

3-17-86 date well completed  
PENTON WELL SERVICE firm name  
PEARL RIVER county well located

LANDOWNER: Wendell Moody  
P.O. Box 818  
PICAYUNE MS 39466  
(mailing address)

description of formations encountered	depth	
	from	to
CLAY	0	40
SAND	40	55

WELL LOCATION:  
sec. 15 T. 6 N. R. 17 E.  
0 miles 0 of PICAYUNE  
(distance) (direction) (nearest town)

WELL PURPOSE: MONITOR  
(home, irrigation, municipal, industrial)


- WELL COMPLETION DATA:
- (1) diameter (inches) 2
  - (2) total depth (feet) 55
  - (3) static water level (feet) 18' below top of ground.
  - (4) casing PVC 45'  
(material) (depth)  
2" if telescope see back.  
(size)
  - (5) screen 10' 45'  
(length) (depth to top)  
2" PVC  
(size) (material)
  - (6) pump \_\_\_\_\_ (HP) \_\_\_\_\_ (yield gpm)  
(type power)
  - (7) electric log No  
(yes or no)  
(organization running log)
  - (8) how well bottom plugged B.W

DRILLERS REMARKS: This Log  
TIMES 3:3 MONITOR  
WELLS

APR - 1 1986  
Department of Natural Resources  
Bureau of Land and Water Resources

If well telescopes please sketch and show depths.

GROUND LEVEL

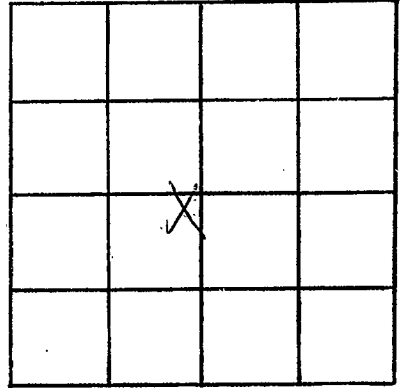

SECTION \_\_\_\_\_

Please indicate well location X.

ADDITIONAL INFORMATION

If more than one screen,  
show locations of each on sketch.