

MISSISSIPPI DEPARTMENT OF NATURAL RESOURCES

Bureau of Land and Water Resources

Southport Mall

P.O. Box 10631

Jackson, Mississippi 39209

WATER WELL DRILLERS LOG

PEARL RIVER
W 2099

4-28 1986 PENTON WELL SERV. PEARL RIVER
date well completed firm name county well located

LANDOWNER: Wendell Moody
P.O. Box 818
PICAYUNE, MS. 39466
(mailing address)

description of formations encountered	from	to
CLAY	0	18
SAND	18	40

WELL LOCATION:
sec. 15 T. 6 S. R. 17 E. of PICAYUNE
0 miles 0 (direction) (nearest town)

WELL PURPOSE: MONITOR
(home, irrigation, municipal, industrial)

- WELL COMPLETION DATA:
- (1) diameter (inches) 2"
 - (2) total depth (feet) 40'
 - (3) static water level (feet) 17' below top of ground.
 - (4) casing PVC, 30' (material) (depth)
2" (size) if telescope see back.
 - (5) screen 10', 30' (length) (depth to top)
2" (size) PVC (material)
 - (6) pump _____ (HP) _____ (yield gpm)
(type power)
 - (7) electric log No (yes or no)
(organization running log)
 - (8) how well bottom plugged B.W.


RECEIVED
MAY 20 1986

Department of Natural Resources
Bureau of Land and Water Resources

DRILLERS REMARKS:

If well telescopes please sketch and show depths.

GROUND LEVEL

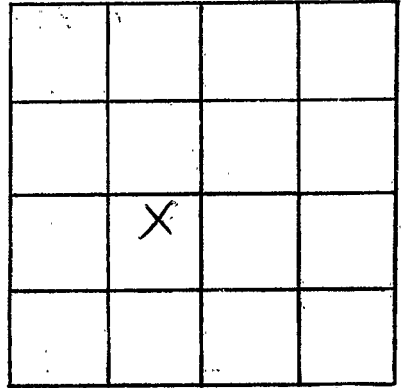

SECTION _____

Please indicate well location X.

ADDITIONAL INFORMATION

If more than one screen,
show locations of each on sketch.