

PEARL RIVER
WJICO

MISSISSIPPI DEPARTMENT OF NATURAL RESOURCES
Bureau of Land and Water Resources
Southport Mall
P.O. Box 10631
Jackson, Mississippi 39209
WATER WELL DRILLERS LOG

May 8 1986
date well completed

Walkers Welding
firm name

Pearl river
county well located

LANDOWNER: Jonh Collins
RT#1 Picayune
2608 NINA Dr.
(mailing address)

description of formations encountered	from	to
<u>White Clay Sand</u>	<u>0</u> <u>15</u>	<u>15</u> <u>50</u>

WELL LOCATION:
sec. 6 T N R. 17 E
S W
0 miles W of picayune
(distance) (direction) (nearest town)

WELL PURPOSE: Home
(home, irrigation, municipal, industrial)

WELL COMPLETION DATA:

(1) diameter (inches) 2"

(2) total depth (feet) 55'

(3) static water level (feet) 15 below above top of ground.

(4) casing PVC 115'
(material) (depth)
 if telescope see back.
(size)

(5) screen 10' 115'
(length) (depth to top)
#10 PVC
(size) (material)

(6) pump 1/2 10 gpm
(HP) (yield gpm)

(type power)

(7) electric log
(yes or no)

(organization running log)

(8) how well bottom plugged Sand Shark


RECEIVED
MAY 20 1986

Department of Natural Resources
Bureau of Land & Water Resources

DRILLERS REMARKS:

If well telescopes please sketch and show depths.

GROUND LEVEL

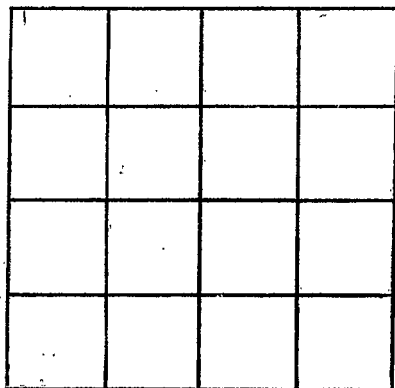

SECTION _____

Please indicate well location X.

ADDITIONAL INFORMATION

If more than one screen,
show locations of each on sketch.