

MISSISSIPPI DEPARTMENT OF NATURAL RESOURCES

Bureau of Land and Water Resources

Southport Mall

P.O. Box 10631

Jackson, Mississippi 39209

WATER WELL DRILLERS LOG

PEARL RIVER  
W 2101

7-20 1986 PENTON WELL SERV. PEARL RIVER  
date well completed firm name county well located

LANDOWNER: <u>Wendell Moody</u>	description of formations encountered	from	to
<u>P.O. Box 818</u>			
<u>PICAYUNE, MS. 39466</u> (mailing address)	<u>CLAY</u>	<u>0</u>	<u>17</u>
	<u>SAND</u>	<u>17</u>	<u>50</u>
	<u>GRAVEL</u>	<u>50</u>	<u>67</u>

WELL LOCATION:  
sec. 15 T. 6 N. R. 17 E.  
S. W.  
0 miles 0 of PICAYUNE  
(distance) (direction) (nearest town)

WELL PURPOSE: MONITOR  
(home, irrigation, municipal, industrial)

- WELL COMPLETION DATA:
- (1) diameter (inches) 2"
  - (2) total depth (feet) 67
  - (3) static water level (feet) 17' below top of ground.
  - (4) casing PVC, 57'  
(material) (depth)
  - 2 if telescope see back.  
(size)
  - (5) screen 10', 57'  
(length) (depth to top)
  - 2" (size), PVC (material)
  - (6) pump \_\_\_\_\_ (HP) \_\_\_\_\_ (yield gpm)  
(type power)
  - (7) electric log NO  
(yes or no)
  - (organization running log)
  - (8) how well bottom plugged B.W.


RECEIVED  
BUREAU OF LAND & WATER RESOURCES  
AUG 1 0 1986

Department of Natural Resources  
Bureau of Land & Water Resources

DRILLERS REMARKS:

If well telescopes please  
sketch and show depths.

GROUND LEVEL

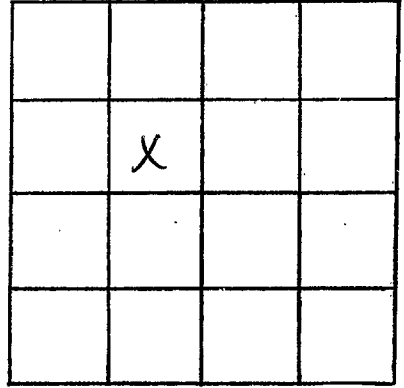

SECTION \_\_\_\_\_

Please indicate well location X.

ADDITIONAL INFORMATION

If more than one screen,  
show locations of each on sketch.