

MISSISSIPPI DEPARTMENT OF NATURAL RESOURCES

Bureau of Land and Water Resources

Southport Mall

P.O. Box 10631

Jackson, Mississippi 39209

WATER WELL DRILLERS LOG

PEARL RIVER
W 2102

7-20 1986 PENTON Well Serv. PEARL RIVER
date well completed firm name county well located

LANDOWNER: <u>Wendell Moody</u> <u>P.O. Box 818</u> <u>PICAYUNE, MS 39466</u> (mailing address)	description of formations encountered	from	to
		<u>CLAY</u>	<u>0</u>
	<u>SAND</u>	<u>40</u>	<u>50</u>

WELL LOCATION:
sec. 15 T. 6 S. R. 17 W.
0 miles 0 of PICAYUNE
(distance) (direction) (nearest town)

WELL PURPOSE: MONITOR
(home, irrigation, municipal, industrial)

- WELL COMPLETION DATA:
- (1) diameter (inches) 2"
 - (2) total depth (feet) 50'
 - (3) static water level (feet) 18' below top of ground.
 - (4) casing PVC, 40'
(material) (depth)
2 If telescope see back.
(size)
 - (5) screen 10', 40'
(length) (depth to top)
2", PVC
(size) (material)
 - (6) pump _____ (HP) _____ (yield gpm)
(type power)
 - (7) electric log NO
(yes or no)
(organization running log)
 - (8) how well bottom plugged BW


DRILLERS LOG
AUG 19 1986

Department of Natural Resources
Bureau of Land & Water Resources

DRILLERS REMARKS:

If well telescopes please sketch and show depths.

GROUND LEVEL

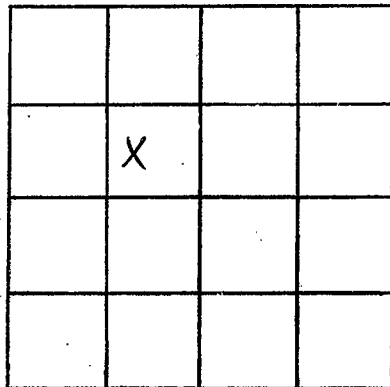

SECTION _____

Please indicate well location X.

ADDITIONAL INFORMATION

If more than one screen,
show locations of each on sketch.