

MISSISSIPPI DEPARTMENT OF NATURAL RESOURCES

Bureau of Land and Water Resources

Southport Mall

P.O. Box 10631

Jackson, Mississippi 39209

WATER WELL DRILLERS LOG

PEARL RIVER  
W 2103

10-13 1986 PENTON WELL SERV. Pearl River  
date well completed firm name county well located

LANDOWNER: Wendell Moody P.O. Box 818 PicAYUNE (mailing address)	description of formations encountered	from	to
	CLAY	0	39
	SAND	39	50
WELL LOCATION: sec. 15 T 6 N R 17 E 0 miles 0 of PicAYUNE (distance) (direction) (nearest town)			
WELL PURPOSE: MONITOR (home, irrigation, municipal, industrial)			
WELL COMPLETION DATA:			
(1) diameter (inches) 2			
(2) total depth (feet) 50'			
(3) static water level (feet) 18 below top of ground.			
(4) casing PVC 40' (material) (depth)			
2 (size) if telescope see back.			
(5) screen 10 40' (length) (depth to top)			
2 PVC (size) (material)			
(6) pump (HP) (yield gpm)			
(type power)			
(7) electric log NO (yes or no)			
(organization running log)			
(8) how well bottom plugged B.W			

RECEIVED


NOV 12 1986

Department of Natural Resources  
Bureau of Land & Water Resources

DRILLERS REMARKS:

If well telescopes please sketch and show depths.

GROUND LEVEL

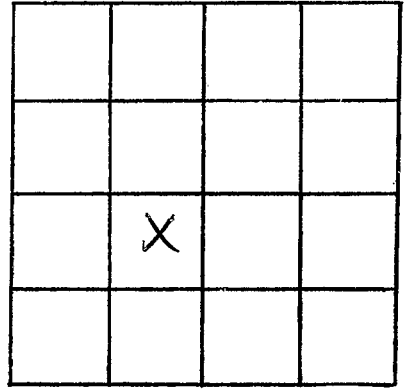

SECTION \_\_\_\_\_

Please indicate well location X.

ADDITIONAL INFORMATION

If more than one screen,  
show locations of each on sketch.