

PEARL RIVER
W 2104

MISSISSIPPI DEPARTMENT OF NATURAL RESOURCES
 Bureau of Land and Water Resources
 Southport Mall
 P.O. Box 10631
 Jackson, Mississippi 39209
WATER WELL DRILLERS LOG

10-16 1986 PENTON WELL SERV. PEARL RIVER
 date well completed firm name county well located

LANDOWNER: CARLTON POMELOUS
RT. 6 BOX 96 F
PICAYUNE, MS. 39466
 (mailing address)

description of formations encountered	from	to
<u>CLAY</u>	<u>0</u>	<u>15</u>
<u>SAND</u>	<u>15</u>	<u>48</u>

WELL LOCATION:
 sec. 7 T 6 R 17
2 miles WEST of PICAYUNE
 (distance) (direction) (nearest town)

WELL PURPOSE: HOME
 (home, irrigation, municipal, industrial)

WELL COMPLETION DATA:

- (1) diameter (inches) 2
- (2) total depth (feet) 48
- (3) static water level (feet) 10 below top of ground.
- (4) casing PVC 38'
 (material) (depth)
2 if telescope see back.
 (size)
- (5) screen 10 38'
 (length) (depth to top)
2 PVC
 (size) (material)
- (6) pump _____ (HP) _____ (yield gpm)
 (type power)
- (7) electric log NO
 (yes or no)
- (8) how well bottom plugged B.W.

DRILLERS REMARKS:


RECEIVED

NOV 12 1986

Department of Natural Resources
 Bureau of Land & Water Resources

If well telescopes please sketch and show depths.

GROUND LEVEL

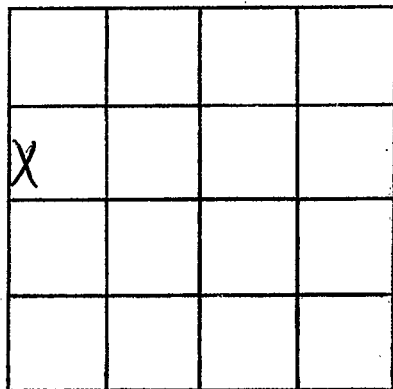

SECTION _____

Please indicate well location X.

ADDITIONAL INFORMATION

If more than one screen,
show locations of each on sketch.