

MISSISSIPPI DEPARTMENT OF NATURAL RESOURCES

Bureau of Land and Water Resources

Southport Mall

P.O. Box 10631

Jackson, Mississippi 39209

WATER WELL DRILLERS LOG

PEARL RIVER  
W 2105

10-30-86 date well completed  
1986 PENTON WELL SERV. firm name  
PEARL RIVER county well located

LANDOWNER: CARL JOHNSON  
306 HAMPTON  
HOUMA, LA. 70364  
(mailing address)

description of formations encountered	from	to
CLAY	0	15
SAND & GRAVEL	15	85
CLAY	85	320
SAND	320	430

WELL LOCATION:  
sec 20 T 6 S R 17 E  
1 miles S.W. of PICAYUNE  
(distance) (direction) (nearest town)

WELL PURPOSE: HOME  
(home, irrigation, municipal, industrial)

WELL COMPLETION DATA:

- (1) diameter (inches) 2
- (2) total depth (feet) 430
- (3) static water level (feet) 13 below top of ground.
- (4) casing PVC 420' (material) (depth)  
2 (size) if telescope see back.
- (5) screen 10' 420' (length) (depth to top)  
2 PVC (size) (material)
- (6) pump 1/2 (HP) (yield gpm)  
Elec (type power)
- (7) electric log No (yes or no)  
(organization running log)
- (8) how well bottom plugged B.W.

RECEIVED


NOV 12 1986

Department of Natural Resources  
Bureau of Land & Water Resources

DRILLERS REMARKS:

If well telescopes please sketch and show depths.

GROUND LEVEL

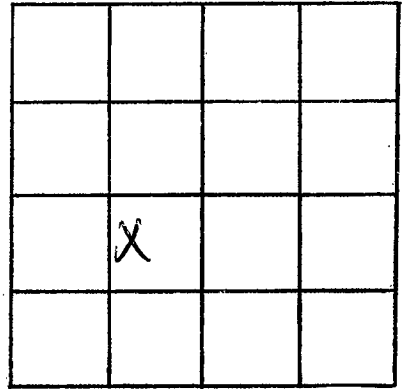

SECTION \_\_\_\_\_

Please indicate well location X.

ADDITIONAL INFORMATION

If more than one screen,  
show locations of each on sketch.