

MISSISSIPPI DEPARTMENT OF NATURAL RESOURCES

Bureau of Land and Water Resources

P.O. Box 10631

Jackson, Mississippi 39209

WATER WELL DRILLERS LOG

COUNTY WELL LOCATED PEARL RIVER	
WELL NUMBER W 2106	CODED
DATE WELL COMPLETED 10-13-86	

PERMIT NUMBER 0428
NAME OF DRILLING FIRM WALKER WELL DRILLING

NAME & MAILING ADDRESS OF LANDOWNER Richard Sellers 508 Newwood Street			
WELL LOCATION: SEC	TOWNSHIP	RANGE	
	6 N S	17 E W	
DISTANCE	DIRECTION	NEAREST TOWN	
	Miles	of PICAYUNE	
OTHER LANDMARK			
WELL PURPOSE: Home, Irrigation, Municipal, Industrial, Fish Pond, etc. HEAT PUMP			

PUMP DATA		
PUMP TYPE (Circle One): Submersible, Turbine, Jet Flowing Well, Other (Describe) HK		
POWER TYPE (Circle One): Electric , Tractor, Diesel, Gasoline, Butane, Other (Describe)		
Pump Capacity (GPM) 8	No. of Stages 1	Setting Depth 30 FT.
PUMP TEST		
Well yielded _____ GPM with a drawdown of _____ ft. after _____ hours of pumping		

WELL DATA		
Well Depth 54'	Casing Diameter (In.) 2"	Casing Length (Ft.) 44'
Type of Casing PVC	Hole Depth 55'	Depth to Static Water Level 20'
TYPE OF COMPLETION: (Circle One or More): Gravel Packed, Underreamed, Telescoped, Natural Development , Open Hole, Other (Describe) NER		
Top of Lap Pipe or Reduction in Casing		
FEET		IF TELESCOPED OR MORE THAN ONE SCREEN: USE BACK PAGE

LOG DATA	
TYPE OF LOG RUN (Circle One): No Log Run, Electric, Gamma Ray, Density, Sonic, Neutron, Other (Describe)	
Name of Organization Running Log	

SCREEN DATA		
Diameter - Inches 2"	Length - Feet 10'	Slot Size - Inches #10
Screen Type SLOT		Depth to Bottom - Feet 54'

GEOLOGIC DATA (Office Use Only)			
Surface Elev.	Geologic Unit	Unit Thickness	Depth to Top
Subs. SWL	Date	Analysis	Aquifer Test

Driller's Remarks


RECEIVED

DESCRIPTION OF FORMATIONS ENCOUNTERED	FROM	TO	FORMATIONS (Continued)	FROM	TO
BLUE CLAY	0	15	NOV 20 1986 Department of Natural Resources Bureau of Land & Water Resources		
WHIT CLAY	15	25			
SAWD	25	40			
SAWD + GRAVEL	40	54'			

IF MORE SPACE IS NEEDED, USE BACK

If well telescopes please
sketch and show depths.

GROUND LEVEL

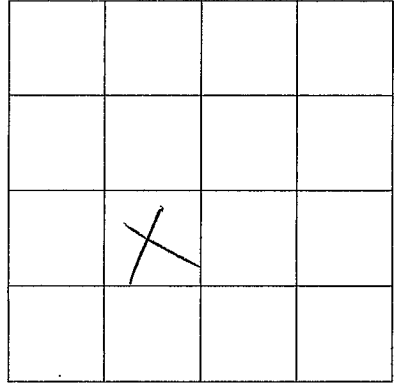

SECTION _____

Please indicate well location X.

ADDITIONAL INFORMATION

If more than one screen,
show location of each on sketch.