

MISSISSIPPI DEPARTMENT OF NATURAL RESOURCES

Bureau of Land and Water Resources

Southport Mall

P.O. Box 10631

Jackson, Mississippi 39209

WATER WELL DRILLERS LOG

Pearl River
W 2107

10/19
date well completed

1986 Bud Porter Water Well
firm name

Pearl River
county well located


LANDOWNER: Dorrell Green
1232 Stumwood Dr.
Picayune
(mailing address)

description of formations encountered	from	to
<u>Red shale</u>	<u>012</u>	
<u>White sand</u>	<u>1262</u>	

WELL LOCATION:
sec 33 T 7 N R 18 E
S W
4 miles West of Picayune
(distance) (direction) (nearest town)

WELL PURPOSE: home
(home, irrigation, municipal, industrial)

- WELL COMPLETION DATA:
- (1) diameter (inches) 2
 - (2) total depth (feet) 62
 - (3) static water level (feet) 8 below above top of ground.
 - (4) casing pc, 62
(material) (depth)
(size) if telescope see back.
 - (5) screen 5, 5-7
(length) (depth to top)
12, pc
(size) (material)
 - (6) pump 1/2, 600
(HP) (yield gpm)
Elect
(type power)
 - (7) electric log no
(yes or no)

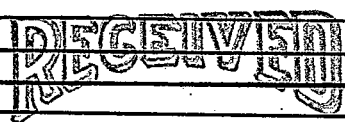

JUN 12 1967


Department of Natural Resources
Bureau of Land & Water Resources

(organization running log)
(8) how well bottom plugged Sand

DRILLERS REMARKS: Start

If well telescopes please sketch and show depths.

GROUND LEVEL

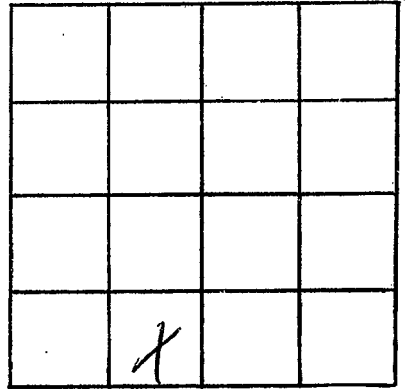

SECTION _____

Please indicate well location X.

ADDITIONAL INFORMATION

If more than one screen, show locations of each on sketch.