

MISSISSIPPI DEPARTMENT OF NATURAL RESOURCES

Bureau of Land and Water Resources

Southport Mall

P.O. Box 10631

Jackson, Mississippi 39209

WATER WELL DRILLERS LOG

BUD PENTON & SONS

Water Well Service Pearl River
 firm name county well located
 Rt. 4, Box 402

PEARL RIVER
 W 2109

6/14 1987
 date well completed

LANDOWNER: Jessie Lee Carter
R.T. 3 Box
Carriere Miss 39426
 (mailing address)

description of formations	from	to
Red Shale	0	22
White sand	22	60
Blue shale	60	230
gray sand	230	280


WELL LOCATION:
 sec 3 T 7 N R 17 E
2 miles South of Carriere
 (distance) (direction) (nearest town)

WELL PURPOSE: home
 (home, irrigation, municipal, industrial)

- WELL COMPLETION DATA:
- (1) diameter (inches) 2" 2"
 - (2) total depth (feet) 28
 - (3) static water level (feet) 9 below top of ground.
 - (4) casing PVC 280
 (material) (depth)
 (size) if telescope see back.
 - (5) screen 10 270
 (length) (depth to top)
1/2" PVC
 (size) (material)
 - (6) pump 1/2 10
 (HP) (yield gpm)
Elect
 (type power)
 - (7) electric log no
 (yes or no)

(organization running log)
 (8) how well bottom plugged sand
sharp

DRILLERS REMARKS:

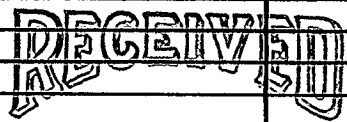


AUG 13 1987

Department of Natural Resources
 Bureau of Land & Water Resources

If well telescopes please sketch and show depths.

GROUND LEVEL

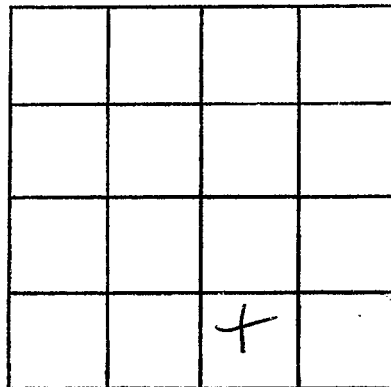

SECTION _____

Please indicate well location X.

ADDITIONAL INFORMATION

If more than one screen,
show locations of each on sketch.