

MISSISSIPPI DEPARTMENT OF NATURAL RESOURCES

Bureau of Land and Water Resources

COUNTY WELL LOCATED
Pearl River

WELL NUMBER
W 2113

DATE WELL COMPLETED
1/29/87

PERMIT NUMBER

POUNCEY WATER WELL DRILLING
NAME OF DRILLING FIRM

ROUTE 3, BOX 461
PICAYUNE, MS. 39466

P.O. Box 10631
Jackson, Mississippi 39209
WATER WELL DRILLERS LOG

NAME & MAILING ADDRESS OF LANDOWNER
Bobby Stockstill
Palestine Rd.

WELL LOCATION: SEC 6 TOWNSHIP 6 N RANGE 17 E
S 17 SW

DISTANCE 1 Miles DIRECTION S of NEAREST TOWN Industrial

OTHER LANDMARK
Stockstill Branch

WELL PURPOSE: Home, Irrigation, Municipal, Industrial, Fish Pond, etc.
Farm

PUMP DATA

PUMP TYPE (Circle One):
Submersible, Turbine, Jet, Flowing Well,
Other (Describe) _____

POWER TYPE (Circle One):
 Electric, Tractor, Diesel, Gasoline, Butane,
Other (Describe) _____

Pump Capacity (GPM) 2 No. of Stages 40 Setting Depth 40 FT.

PUMP TEST
Well yielded 16 GPM with
a drawdown of: _____ ft.
after _____ hours of pumping

WELL DATA

Well Depth 370	Casing Diameter (In.) 2	Casing Length (Ft.) 370
Type of Casing PVC	Hole Depth 370	Depth to Static Water Level 10

TYPE OF COMPLETION: (Circle One or More):
 Gravel Packed, Underreamed, Telescoped,
 Natural Development, Open Hole, Other
(Describe) _____

Top of Lap Pipe or Reduction in Casing
FEET IF TELESCOPED OR MORE THAN ONE SCREEN: USE BACK PAGE

LOG DATA

TYPE OF LOG RUN (Circle One):
 No Log Run, Electric, Gamma Ray, Density, Sonic, Neutron,
Other (Describe) _____

Name of Organization Running Log _____

SCREEN DATA

Diameter - Inches 2	Length - Feet 10	Slot Size - Inches 1/8" x 1/2"
Screen Type PVC Wrap	Depth to Bottom - Feet 370	

GEOLOGIC DATA (Office Use Only)

Surface Elev.	Geologic Unit	Unit Thickness	Depth to Top
Subs. SWL	Date	Analysis	Aquifer Test

Driller's Remarks


RECEIVED

DESCRIPTION OF FORMATIONS ENCOUNTERED	FROM	TO	FORMATIONS (Continued)
<i>Topsoil</i>	<i>0</i>	<i>4</i>	AUG 10 1987 Department of Natural Resources Bureau of Land & Water Resources
<i>SD gravel</i>	<i>8</i>	<i>18</i>	
<i>Clay</i>	<i>18</i>	<i>270</i>	
<i>good SD</i>	<i>270</i>	<i>370</i>	

IF MORE SPACE IS NEEDED, USE BACK

If well telescopes please
sketch and show depths.

GROUND LEVEL

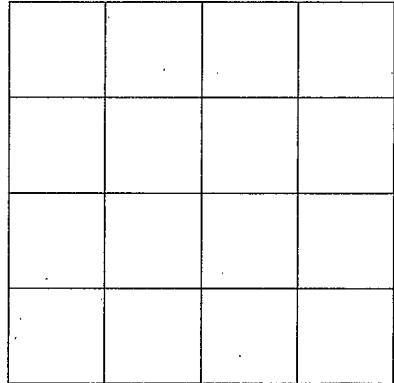

SECTION _____

Please indicate well location X.

ADDITIONAL INFORMATION

If more than one screen,
show location of each on sketch.