

P. River  
W 217

MISSISSIPPI DEPARTMENT OF NATURAL RESOURCES  
Bureau of Land and Water Resources  
Southport Mall  
P.O. Box 10631  
Jackson, Mississippi 39209  
WATER WELL DRILLERS LOG

date well completed

19<sup>85</sup> Budgeron Gas

firm name

Pearl River  
county well located

LANDOWNER: John Peretto

description of formations encountered

from to

Divy 11 North  
Picoue Miss.  
(mailing address)

<u>Red shale</u>	<u>0</u>	<u>15'</u>
<u>White sand</u>	<u>15</u>	<u>22</u>
<u>Blue shale</u>	<u>22</u>	<u>125</u>
<u>Red sand</u>	<u>125</u>	<u>185</u>
<u>Blue shale</u>	<u>185</u>	<u>300</u>
<u>Grey sand</u>	<u>300</u>	<u>360</u>

WELL LOCATION:

sec 2 T 6 N R 17 E  
S W  
1 miles N of Picoue  
(distance) (direction) (nearest town)

WELL PURPOSE: Drinking Water  
(home, irrigation, municipal, industrial)

WELL COMPLETION DATA:

- (1) diameter (inches) 2"
- (2) total depth (feet) 360
- (3) static water level (feet) 22 below above top of ground.
- (4) casing pvc 340  
(material) (depth)
- (size) if telescope see back.
- (5) screen 10 340  
(length) (depth to top)
- 12 pvc  
(size) (material)
- (6) pump no  
(HP) (yield gpm)

(type power)  
(7) electric log Elect  
(yes or no)

(organization running log)  
(8) how well bottom plugged Sand  
short

DRILLERS REMARKS: no pump  
furnished


RECEIVED

JUN 16 1985

Department of Natural Resources  
Bureau of Land & Water Resources

If well telescopes please sketch and show depths.

GROUND LEVEL

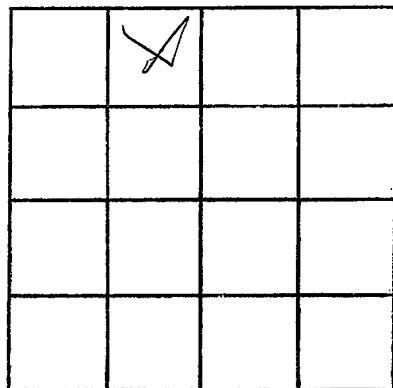

SECTION \_\_\_\_\_

Please indicate well location X.

ADDITIONAL INFORMATION

If more than one screen,  
show locations of each on sketch.