

P. Ryber
W 2123

MISSISSIPPI DEPARTMENT OF NATURAL RESOURCES
Bureau of Land and Water Resources
Southport Mall
P.O. Box 10631
Jackson, Mississippi 39209
WATER WELL DRILLERS LOG

1-14- date well completed 1989 Bud Penton firm name Pearl River county well located

LANDOWNER: John Rush
209 Hunting Dr
Picopino Miss.
(mailing address)

description of formations encountered	from	to
<u>white shale</u>	<u>0</u>	<u>8</u>
<u>white sand</u>	<u>8</u>	<u>57</u>
<u>blue shale</u>	<u>57</u>	<u>120</u>
<u>blue sand</u>	<u>120</u>	<u>135</u>
<u>blue shale</u>	<u>135</u>	<u>265</u>
<u>blue sand</u>	<u>265</u>	<u>375</u>

WELL LOCATION:
sec. 27 T-7 N R-10 E
S W
2 1/2 miles West of Picopino
(distance) (direction) (nearest town)

WELL PURPOSE: Home
(home, irrigation, municipal, industrial)

WELL COMPLETION DATA:
(1) diameter (inches) 2 1/2
(2) total depth (feet) 375
(3) static water level (feet) 6 below above-
top of ground.
(4) casing PVC, 375,
(material) (depth)
(size) if telescope see back.
(5) screen 10, 365
(length) (depth to top)
12, PVC
(size) (material)
(6) pump 1/2, 8
(HP) (yield gpm)
Elect.
(type power)
(7) electric log no
(yes or no)
(organization running log)
(8) how well bottom plugged sand
shale


RECEIVED
MAR 27 1989

Department of Natural Resources
Bureau of Land & Water Resources

DRILLERS REMARKS:

If well telescopes please sketch and show depths.

GROUND LEVEL

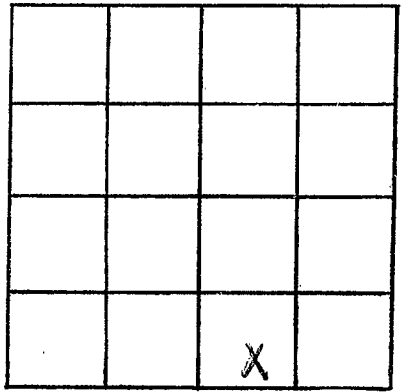

SECTION _____

Please indicate well location X.

ADDITIONAL INFORMATION

If more than one screen,
show locations of each on sketch.