

MISSISSIPPI DEPARTMENT OF NATURAL RESOURCES

Bureau of Land and Water Resources

Southport Mall

P.O. Box 10631

Jackson, Mississippi 39209

WATER WELL DRILLERS LOG

P. River  
W 2125

4/20 - 89 Bud Perston Pearl River  
date well completed firm name county well located

LANDOWNER: Mrs Clara Howard  
Clara  
102 League Street  
Picayune Miss 39460  
(mailing address)

WELL LOCATION:  
sec. 7 T 6 N R. 18 E  
2 miles 6 Picayune  
(distance) (direction) (nearest town)

WELL PURPOSE: none  
(home, irrigation, municipal, industrial)

WELL COMPLETION DATA:

(1) diameter (inches) 2"

(2) total depth (feet) 930

(3) static water level (feet) 14 1/2 below  
top of ground. above

(4) casing pvc 930  
(material) (depth)

(size) If telescope see back.

(5) screen 20 910  
(length) (depth to top)

12 pvc  
(size) (material)

(6) pump no  
(HP) (yield gpm)

(type power)

(7) electric log no  
(yes or no)

(organization running log)

(8) how well bottom plugged hard

description of formations encountered	from	to
<u>W. Kitt's shell</u>	<u>0</u>	<u>10</u>
<u>sand &amp; gravel</u>	<u>10</u>	<u>52</u>
<u>Blue shell</u>	<u>52</u>	<u>273</u>
<u>Blue sand</u>	<u>273</u>	<u>457</u>
<u>Blue shell</u>	<u>457</u>	<u>609</u>
<u>Blue sand</u>	<u>609</u>	<u>665</u>
<u>Blue shell</u>	<u>665</u>	<u>840</u>
<u>gray sand</u>	<u>840</u>	<u>930</u>

RECEIVED


MAY 24 1989

Department of Natural Resources  
Bureau of Land & Water Resources

DRILLERS REMARKS:

If well telescopes please sketch and show depths.

GROUND LEVEL

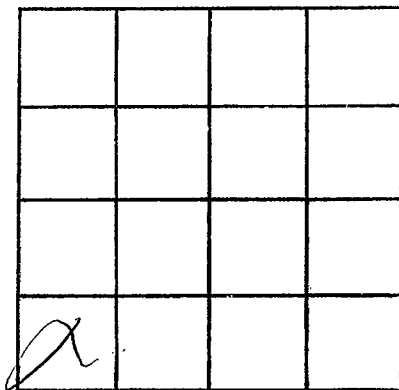

SECTION \_\_\_\_\_

Please indicate well location X.

ADDITIONAL INFORMATION

If more than one screen,  
show locations of each on sketch.