

**P. River**  
**W** 2129

MISSISSIPPI DEPARTMENT OF NATURAL RESOURCES  
 Bureau of Land and Water Resources  
 Southport Mall  
 P.O. Box 10631  
 Jackson, Mississippi 39209  
**WATER WELL DRILLERS LOG**

7/11/90 date well completed 1990 Bud Perton firm name Pearl River county well located

LANDOWNER: Marion Seance  
P.O. Box 187 Michoud  
Miss.  
 (mailing address)

description of formations encountered	from	to
white shale	0	5'
sand & gravel	5'	105'
blue shale	105'	230'
grey sand	230'	292'
blue shale	292'	390'
grey sand	390'	468'

WELL LOCATION:  
 sec. 2 T 7 N R. 17 E  
                   S                  W  
5 miles S of Acoguch  
 (distance) (direction) (nearest town)

WELL PURPOSE: home  
 (home, irrigation, municipal, industrial)

- WELL COMPLETION DATA:
- (1) diameter (inches) 2"
  - (2) total depth (feet) 468
  - (3) static water level (feet) 9 below above top of ground.
  - (4) casing pvc 468  
 (material) (depth)  
 (size) if telescope see back.
  - (5) screen 10 458  
 (length) (depth to top)  
10  
 (size) (material)
  - (6) pump 1 650  
 (HP) (yield gpm)  
Elect  
 (type power)
  - (7) electric log no  
 (yes or no)  
 (organization running log)
  - (8) how well bottom plugged: sand  
mark

**RECEIVED**  
**FILE**


OCT 15 1990

Department of Natural Resources  
 Bureau of Land & Water Resources

DRILLERS REMARKS:

If well telescopes please sketch and show depths.

GROUND LEVEL

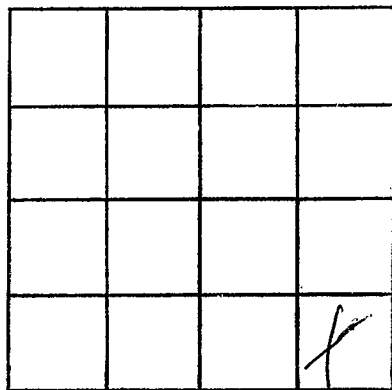

SECTION \_\_\_\_\_

Please indicate well location X.

ADDITIONAL INFORMATION

If more than one screen,  
show locations of each on sketch.