

MISSISSIPPI DEPARTMENT OF NATURAL RESOURCES

Bureau of Land and Water Resources

P.O. Box 10631

Jackson, Mississippi 39209

WATER WELL DRILLERS LOG

COUNTY WELL LOCATED <i>Paul Jones</i>	
WELL NUMBER <i>W</i>	CODED
DATE WELL COMPLETED <i>9-13-90</i>	

PERMIT NUMBER
NAME OF DRILLING FIRM <i>Powney</i>

NAME & MAILING ADDRESS OF LANDOWNER <i>Joseph Miller - Howard Rd. Miss. Pines - Preogin.</i>			
WELL LOCATION:	SEC <i>24</i>	TOWNSHIP <i>6 N</i>	RANGE <i>17C E</i>
DISTANCE	DIRECTION	NEAREST TOWN	
<i>1/2</i> Miles	<i>S</i>	<i>WRTN</i>	
OTHER LANDMARK <i>1st. left post AM Vet - VFW</i>			
WELL PURPOSE: <input type="checkbox"/> Horse Irrigation, <input type="checkbox"/> Municipal, <input type="checkbox"/> Industrial, <input type="checkbox"/> Fish Pond, etc.			

PUMP DATA		
PUMP TYPE (Circle One): Submersible, Turbine, Jet, Flowing Well, Other (Describe) _____		
POWER TYPE (Circle One): Electric, Tractor, Diesel, Gasoline, Butane, Other (Describe) _____ H/P _____		
Pump Capacity (GPM)	No. of Stages	Setting Depth FT.
PUMP TEST <i>owner had own</i>		
Well yielded <i>flow</i> GPM with a drawdown of _____ ft. after _____ hours of pumping		

WELL DATA		
Well Depth <i>484</i>	Casing Diameter (In.) <i>2</i>	Casing Length (Ft.) <i>47K</i>
Type of Casing <i>PVC</i>	Hole Depth <i>484</i>	Depth to Static Water Level <i>24</i>
TYPE OF COMPLETION: (Circle One or More): <input checked="" type="checkbox"/> Gravel Packed, <input type="checkbox"/> Underreamed, <input type="checkbox"/> Telescoped, <input type="checkbox"/> Natural Development, <input type="checkbox"/> Open Hole, <input type="checkbox"/> Other (Describe) _____		
Top of Lap Pipe or Reduction in Casing FEET <input type="checkbox"/> IF TELESCOPED OR MORE THAN ONE SCREEN: USE BACK PAGE		

LOG DATA	
TYPE OF LOG RUN (Circle One): No Log Run, Electric, Gamma Ray, Density, Sonic, Neutron, Other (Describe) _____	
Name of Organization Running Log	

SCREEN DATA		
Diameter - Inches <i>2</i>	Length - Feet <i>10</i>	Slot Size - inches <i>5-008 5-010</i>
Screen Type <i>PVC wrap.</i>	Depth to Bottom - Feet <i>484</i>	

GEOLOGIC DATA (Office Use Only)			
Surface Elev.	Geologic Unit	Unit Thickness	Depth to Top
Subs. SWL	Date	Analysis	Aquifer Test
Driller's Remarks <i>Mr. Miller had his own pump.</i>			

DESCRIPTION OF FORMATIONS ENCOUNTERED	FROM	TO	FORMATIONS (continued)	FROM	TO
<i>TOP</i>	<i>0</i>	<i>15</i>	<i>set to sd.</i>	<i>446</i>	<i>484</i>
<i>sd gravel</i>	<i>15</i>	<i>86</i>			
<i>clay</i>	<i>86</i>	<i>208</i>			
<i>sety - lil sd.</i>	<i>208</i>	<i>240</i>			
<i>clay</i>	<i>240</i>	<i>362</i>			
<i>hd sd.</i>	<i>362</i>	<i>446</i>			

RECEIVED


OCT 19 1990

Department of Natural Resources
Bureau of Land & Water Resources

IF MORE SPACE IS NEEDED, USE BACK

If well telescopes please
sketch and show depths.

GROUND LEVEL

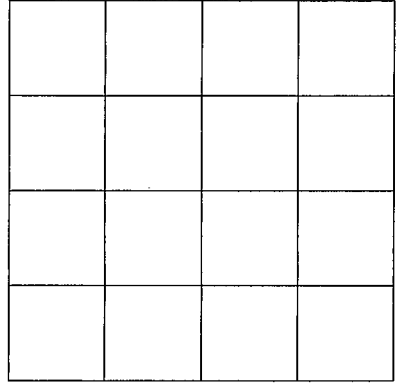

SECTION _____

Please indicate well location X.

ADDITIONAL INFORMATION

If more than one screen,
show location of each on sketch.