

MISSISSIPPI DEPARTMENT OF NATURAL RESOURCES

Bureau of Land and Water Resources

Southport Mall

P.O. Box 10631

Jackson, Mississippi 39209

WATER WELL DRILLERS LOG

Peard River
W 2138

4/3-92 19 Bud Denton & Son Peard River
 date well completed firm name county well located

LANDOWNER: Eddie Creek
Picayune Miss
Richardson Rd
 (mailing address)


WELL LOCATION:
 sec. 2 T 6 N R. 17 E
1 1/2 miles N picayune
 (distance) (direction) (nearest town)

WELL PURPOSE: home
 (home, irrigation, municipal, industrial)

WELL COMPLETION DATA:

- (1) diameter (inches) 2"
- (2) total depth (feet) 1196
- (3) static water level (feet) 8 below/above top of ground.
- (4) casing pvc, 1196,
 (material) (depth)
 (size) If telescope see back.
- (5) screen 20', 1176
 (length) (depth to top)
12, pvc
 (size) (material)
- (6) pump 1/2, 450
 (HP) (yield gpm)
elect.
 (type power)
- (7) electric log no
 (yes or no)
- (organization running log)
- (8) how well bottom plugged sand
sharp

description of formations encountered	from	to
<u>white shale</u>	<u>0</u>	<u>16</u>
<u>white sand</u>	<u>16</u>	<u>28</u>
<u>blue shale</u>	<u>28</u>	<u>294</u>
<u>gray sand</u>	<u>294</u>	<u>360</u>
<u>blue shale</u>	<u>360</u>	<u>462</u>
<u>gray sand</u>	<u>462</u>	<u>500</u>
<u>blue shale</u>	<u>500</u>	<u>568</u>
<u>gray sand</u>	<u>568</u>	<u>615</u>
<u>blue shale</u>	<u>615</u>	<u>980</u>
<u>gray sand</u>	<u>980</u>	<u>1040</u>
<u>blue shale</u>	<u>1040</u>	<u>1120</u>
<u>gray sand</u>	<u>1120</u>	<u>1196</u>

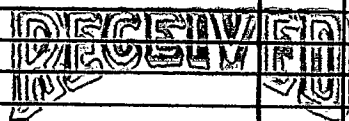

MAY 26 1992

Dept. of Environmental Quality
 Bureau of Land & Water Resources

DRILLERS REMARKS:

If well telescopes please sketch and show depths.

GROUND LEVEL

		X	

SECTION _____

Please indicate well location X.

ADDITIONAL INFORMATION

If more than one screen,
show locations of each on sketch.