

MISSISSIPPI DEPARTMENT OF NATURAL RESOURCES

Bureau of Land and Water Resources

Southport Mall

P.O. Box 10631

Jackson, Mississippi 39209

WATER WELL DRILLERS LOG

Road Run
W 2139

2/27
 date well completed

19 92 Bad Pertum
 firm name

Pearl River
 county well located

LANDOWNER: J.C. Stockstill
P.O. Box 332 Picayune
MS
 (mailing address)

WELL LOCATION:
 sec. 17 T. 6 N R. 17 E
1 miles West of Picayune
 (distance) (direction) (nearest town)

WELL PURPOSE: home
 (home, irrigation, municipal, industrial)


WELL COMPLETION DATA:

- (1) diameter (inches) 3"
- (2) total depth (feet) 1196
- (3) static water level (feet) 12 1/2 ^{below} above top of ground.
- (4) casing PVC 1196
 (material) (depth)
- (size) If telescope see back.
- (5) screen 20 1176
 (length) (depth to top)
12 SS steel
 (size) (material)
- (6) pump 70
 (HP) (yield gpm)
70
 (type power)
- (7) electric log no
 (yes or no)

(organization running log)

(8) how well bottom plugged stand
short

description of formations encountered	from	to
white shale	0	30
white sand	30	60
blue shale	60	165
blue sand	165	190
blue shale	190	290
gray sand	290	360
gray shale	360	462
gray sand	463	525
blue shale	525	580
gray sand	580	630
blue shale	630	770
gray sand	770	820
blue shale	820	861
gray sand	861	936
blue shale	935	990
gray sand	990	1057
blue shale	1057	1080
gray sand	1080	1196

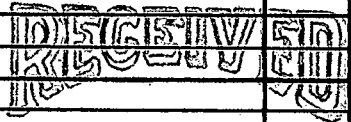


APR 29 1992

Dept. of Environmental Quality
 Bureau of Land & Water Resources

DRILLERS REMARKS:

If well telescopes please
sketch and show depths.

GROUND LEVEL

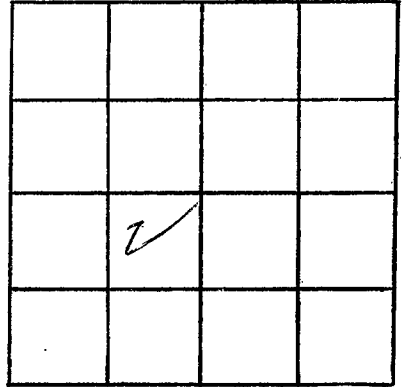

SECTION 17

Please indicate well location X.

ADDITIONAL INFORMATION

If more than one screen,
show locations of each on sketch.