

MISSISSIPPI DEPARTMENT OF NATURAL RESOURCES

Bureau of Land and Water Resources

Southport Mall

P.O. Box 10631

Jackson, Mississippi 39209

WATER WELL DRILLERS LOG

Paul Penon
W 2140

1/27 1992 Paul Penon Pearl River
 date well completed firm name county well located

LANDOWNER: Brenda Block
PO Box 914 Pecque
Miss.
 (mailing address)

description of formations encountered	from	to
<u>Red shale</u>	<u>0</u>	<u>8</u>
<u>white sand</u>	<u>8</u>	<u>25</u>
<u>blue shale</u>	<u>25</u>	<u>230</u>
<u>gray sand</u>	<u>230</u>	<u>298</u>


WELL LOCATION:
 sec 6 T 7 N R 17 E
 S W
2 miles West of Pecque
 (distance) (direction) (nearest town)

WELL PURPOSE: home
 (home, irrigation, municipal, industrial)

- WELL COMPLETION DATA:
- (1) diameter (inches) 2"
 - (2) total depth (feet) 298
 - (3) static water level (feet) 8 below above top of ground.
 - (4) casing pvc, 298,
 (material) (depth)
 (size) If telescope see back.
 - (5) screen 10, 288
 (length) (depth to top)
12, pvc
 (size) (material)
 - (6) pump 1/2, 420
 (HP) (yield gpm)
Elect
 (type power)
 - (7) electric log no
 (yes or no)

(organization running log)
 (8) how well bottom plugged sand
shale

DRILLERS REMARKS:

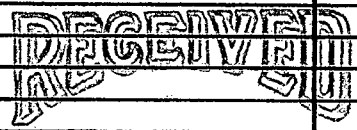


APR 29 1992

Dept. of Environmental Quality
 Bureau of Land & Water Resources

If well telescopes please
sketch and show depths.

GROUND LEVEL

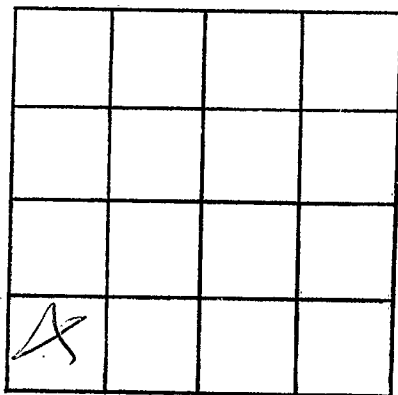

SECTION 6

Please indicate well location X.

ADDITIONAL INFORMATION

If more than one screen,
show locations of each on sketch.