

MISSISSIPPI DEPARTMENT OF NATURAL RESOURCES
Bureau of Land and Water Resources

P.O. Box 10631
Jackson, Mississippi 39209
WATER WELL DRILLERS LOG

COUNTY WELL LOCATED <i>Pearl River</i>		PERMIT NUMBER
WELL NUMBER <i>W 2160</i>	CODED	
DATE WELL COMPLETED <i>6-3-97</i>		NAME OF DRILLING FIRM <i>Walbers Welding</i>
		<i>Carriere, Miss.</i>

NAME & MAILING ADDRESS OF LANDOWNER <i>Gene Combs</i>		
<i>1000 Magnolia St.</i>		
<i>Picayune, Miss. 39426</i>		
WELL LOCATION:	SEC	TOWNSHIP RANGE
	<i>4</i>	<i>6 N 17 E</i>
DISTANCE	DIRECTION	NEAREST TOWN
<i>2</i> Miles	<i>NW</i>	of <i>Picayune</i>
OTHER LANDMARK		
WELL PURPOSE: <input checked="" type="radio"/> Home <input type="radio"/> Irrigation, Municipal, Industrial, Fish Pond, etc.		

PUMP DATA		
PUMP TYPE (Circle One): Submersible, Turbine, <input checked="" type="radio"/> Jet, Flowing Well, Other (Describe) _____		
POWER TYPE (Circle One): Electric, Tractor, Diesel, Gasoline, Butane, Other (Describe) _____		
Pump Capacity (GPM) <i>6</i>	No. of Stages <i>1</i>	Setting Depth <i>30'</i> FT.
PUMP TEST		
Well yielded _____ GPM with a drawdown of _____ ft. after _____ hours of pumping		

WELL DATA		
Well Depth <i>334'</i>	Casing Diameter (In.) <i>2"</i>	Casing Length (Ft.) <i>314'</i>
Type of Casing <i>PVC</i>	Hole Depth <i>334'</i>	Depth to Static Water Level <i>25'</i>
TYPE OF COMPLETION: (Circle One or More): <input checked="" type="radio"/> Gravel Packed, <input type="radio"/> Underreamed, <input type="radio"/> Telescoped, <input type="radio"/> Natural Development, <input type="radio"/> Open Hole, <input type="radio"/> Other (Describe) _____		
Top of Lap Pipe or Reduction in Casing FEET IF TELESCOPED OR MORE THAN ONE SCREEN: USE BACK PAGE		

LOG DATA	
TYPE OF LOG RUN (Circle One): No Log Run, Electric, Gamma Ray, Density, Sonic, Neutron, Other (Describe) _____	
Name of Organization Running Log	

SCREEN DATA		
Diameter - Inches <i>2"</i>	Length - Feet <i>20'</i>	Slot Size - Inches <i>010</i>
Screen Type <i>PVC</i>	Depth to Bottom - Feet <i>334'</i>	

GEOLOGIC DATA (Office Use Only)			
Surface Elev.	Geologic Unit	Unit Thickness	Depth to Top
Subs. SWL	Date	Analysis	Aquifer Test


Driller's Remarks

DESCRIPTION OF FORMATIONS ENCOUNTERED	FROM	TO	FORMATIONS (Continued)	FROM	TO
<i>Black Top soil</i>	<i>0</i>	<i>12'</i>	 JUN 10 1997 Dept. of Environmental Quality Office of Land & Water Resources		
<i>Blue Clay</i>	<i>12'</i>	<i>70'</i>			
<i>Sand & Gravel</i>	<i>70'</i>	<i>108'</i>			
<i>Blue Clay</i>	<i>108'</i>	<i>290'</i>			
<i>Coarse Sand & Gravel</i>	<i>290'</i>	<i>334'</i>			

IF MORE SPACE IS NEEDED, USE BACK

If well telescopes please sketch and show depths.

GROUND LEVEL

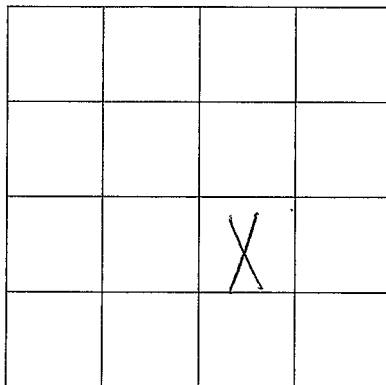

SECTION _____

Please indicate well location X.

ADDITIONAL INFORMATION

If more than one screen,
show location of each on sketch.