

MISSISSIPPI DEPARTMENT OF ENVIRONMENTAL QUALITY

Office of Land and Water Resources

P. O. Box 10631
Jackson, MS 39289-0631
WATER WELL DRILLERS LOG

COUNTY WELL LOCATED
Pearl River

WELL NUMBER N 2162 CODED

DATE WELL COMPLETED
3-26-97

PERMIT NUMBER D-477

NAME OF DRILLING FIRM
DENTON WELL
Nicholson, MS.

NAME & MAILING ADDRESS OF LANDOWNER
Pearson Realty Co.
709 Hwy 435
Picadune, MS. 39466

WELL LOCATION: SEC 24 TOWNSHIP 6 RANGE 17
S W

DISTANCE 1/2 Miles DIRECTION E of NEAREST TOWN PICADUNE

OTHER LANDMARK

WELL PURPOSE: Home Irrigation, Municipal, Industrial, Fish Pond, etc.

PUMP DATA

PUMP TYPE (Circle One):
Submersible, Turbine, Jet, Flowing Well,
Other (Describe) _____

POWER TYPE (Circle One):
 Electric, Tractor, Diesel, Gasoline, Butane,
Other (Describe) _____ H/P 1

Pump Capacity (GPM) 12 No. of Stages 2 Setting Depth 40 FT.

PUMP TEST

Well yielded _____ GPM with
a drawdown of _____ ft.
after _____ hours of pumping

WELL DATA

Well Depth <u>440</u>	Casing Diameter (In.) <u>2</u>	Casing Length (Ft.) <u>430</u>
Type of Casing <u>PVC</u>	Hole Depth <u>440</u>	Depth to Static Water Level <u>25'</u>

TYPE OF COMPLETION: (Circle One or More):
 Gravel Packed, Underreamed, Telescoped,
 Natural Development, Open Hole, Other
(Describe) _____

WELL GROUTED TO A DEPTH OF 10 FEET
Type Grout (circle one): Cement, Bentonite, or Mix

LOG DATA

TYPE OF LOG RUN (Circle One):
Electric, Gamma Ray, Density, Sonic, Neutron,
Other (Describe) _____

Name of Organization Running Log
No Log Run

SCREEN DATA

Diameter - Inches <u>2</u>	Length - Feet <u>10</u>	Slot Size - Inches <u>8</u>
Screen Type <u>PVC</u>	Depth to Bottom - Feet <u>430-440</u>	

GEOLOGIC DATA (Office Use Only)

Surface Elev.	Geologic Unit	Unit Thickness	Depth to Top
Subs. SWL	Date	Analysis	Aquifer Test

Driller's Remarks

DESCRIPTION OF FORMATIONS ENCOUNTERED	FROM	TO
<u>Clay</u>	<u>0</u>	<u>30</u>
<u>Sand</u>	<u>30</u>	<u>70</u>
<u>Clay</u>	<u>70</u>	<u>290</u>
<u>Sand</u>	<u>290</u>	<u>440</u>

FORMATIONS (Continued)

RECEIVED


JUN 26 1997

Dept. of Environmental Quality
Office of Land & Water Resources

IF MORE SPACE IS NEEDED, USE BACK

If well telescopes please sketch and show depths.

GROUND LEVEL

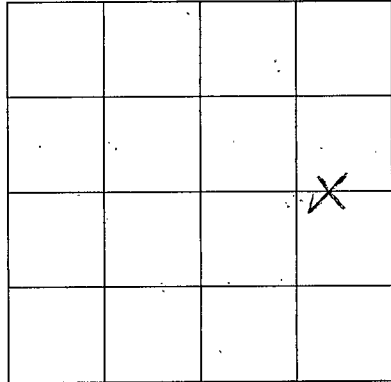

SECTION 24

Please indicate well location X.

ADDITIONAL INFORMATION

PEARSON REAL ESTATE CO.
DU. 17 3 SPEC. HOUSES
TO SELL. ALL 3 ARE
NEXT DOOR TO ONE
ANOTHER. 1/4 MILE EAST
BILL GARRETT AUTO WEX
IN PICTURE (ON LEFT)

#2

If more than one screen,
show location of each on sketch.