

MISSISSIPPI DEPARTMENT OF ENVIRONMENTAL QUALITY

Office of Land and Water Resources

P. O. Box 10631
Jackson, MS 39289-0631
WATER WELL DRILLERS LOG

COUNTY WELL LOCATED <u>Pearl River</u>	
WELL NUMBER <u>W-2179</u>	CODED
DATE WELL COMPLETED <u>5-18-01</u>	

PERMIT NUMBER
NAME OF DRILLING FIRM <u>Bone's Water Well</u>

NAME & MAILING ADDRESS OF LANDOWNER <u>Tricia Gipson</u>			
<u>105 Robert Rd</u>			
<u>Picayune, ms 39466</u>			
WELL LOCATION:	SEC	TOWNSHIP	RANGE
	<u>24</u>	<u>6</u>	<u>N 17 E</u>
DISTANCE	DIRECTION		NEAREST TOWN
<u>2</u> Miles	<u>S</u>		<u>Picayune</u>
OTHER LANDMARK			
WELL PURPOSE: <input checked="" type="checkbox"/> Home, <input type="checkbox"/> Irrigation, <input type="checkbox"/> Municipal, <input type="checkbox"/> Industrial, <input type="checkbox"/> Fish Pond, etc.			

PUMP DATA		
PUMP TYPE (Circle One): Submersible, Turbine, <input checked="" type="radio"/> Jet, Flowing Well, Other (Describe) _____		
POWER TYPE (Circle One): <input checked="" type="radio"/> Electric, Tractor, Diesel, Gasoline, Butane, Other (Describe) _____ H/P <u>1</u>		
Pump Capacity (GPM) <u>5</u>	No. of Stages <u>2</u>	Setting Depth _____ FT.
PUMP TEST Well yielded _____ GPM with a drawdown of _____ ft. after _____ hours of pumping		

WELL DATA		
Well Depth <u>440</u>	Casing Diameter (in.) <u>2</u>	Casing Length (ft.) <u>430</u>
Type of Casing <u>sch 40</u>	Hole Depth <u>440</u>	Depth to Static Water Level <u>40</u>
TYPE OF COMPLETION: (Circle One or More): <input checked="" type="checkbox"/> Gravel Packed, <input type="checkbox"/> Underreamed, <input type="checkbox"/> Telescoped, <input type="checkbox"/> Natural Development, <input type="checkbox"/> Open Hole, <input type="checkbox"/> Other (Describe) _____		

LOG DATA	
TYPE OF LOG RUN (Circle One): No Log Run, Electric, Gamma Ray, Density, Sonic, Neutron, Other (Describe) _____	
Name of Organization Running Log	

WELL GROUTED TO A DEPTH OF <u>10</u> FEET Type Grout (circle one): <input checked="" type="radio"/> Cement, <input type="radio"/> Bentonite, or Mix
--

GEOLOGIC DATA (Office Use Only)			
Surface Elev.	Geologic Unit	Unit Thickness	Depth to Top
Subs. SWL	Date	Analysis	Aquifer Test

SCREEN DATA		
Diameter - Inches <u>2</u>	Length - Feet <u>10</u>	Slot Size - Inches <u>#8</u>
Screen Type <u>sch 40</u>	Depth to Bottom - Feet	

Driller's Remarks
Top of Lap Pipe or Reduction in Casing
FEET <input type="checkbox"/> IF TELESCOPED OR MORE THAN ONE SCREEN: USE BACK PAGE

DESCRIPTION OF FORMATIONS ENCOUNTERED	FROM	TO
<u>Sand + gravel</u>	<u>0</u>	<u>80</u>
<u>clay</u>	<u>80</u>	<u>400</u>
<u>Sand</u>	<u>400</u>	<u>440</u>


FORMATIONS (Continued)	FROM	TO

RECD AUG 24 2001

IF MORE SPACE IS NEEDED, USE BACK

If well telescopes please
sketch and show depths.

GROUND LEVEL

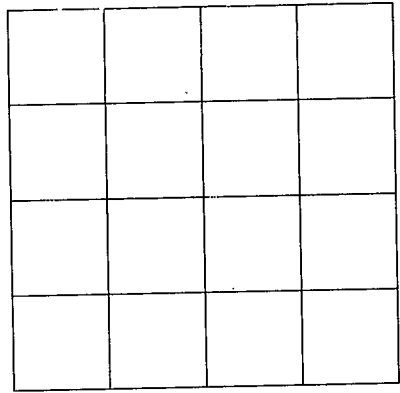

SECTION _____

Please indicate well location X.

ADDITIONAL INFORMATION

If more than one screen,
show location of each on sketch.